






SOUTH PARS GAS FIELD DEVELOPMENT- PHASES 9 & 10, ASSALUYEH-IRAN ONSHORE FACILITIES		 N.I.O.C PARS OIL AND GAS COMPANY
PROJECT NO.: POGC-760-81-156	DOC. CLASS.	SCALE:
 KSB	 OIEC	 IOEC
TITLE: DIMENSIONAL OUTLINE DRAWING SEA WATER BOOSTER PUMPS		ITEM-NO.: 125-P-102A/B/C
DWG NO: VP-6340S-125-P102-001	SHEET NO. 1 OF 1 REV. 3	



*TO MAINTAIN INDICATED SPECIFICATIONS -
ATTACH AN EVEN PIPE WITH A LENGTH OF AT
LEAST 3X INNER DIAMETER OF SUCTION PIPE



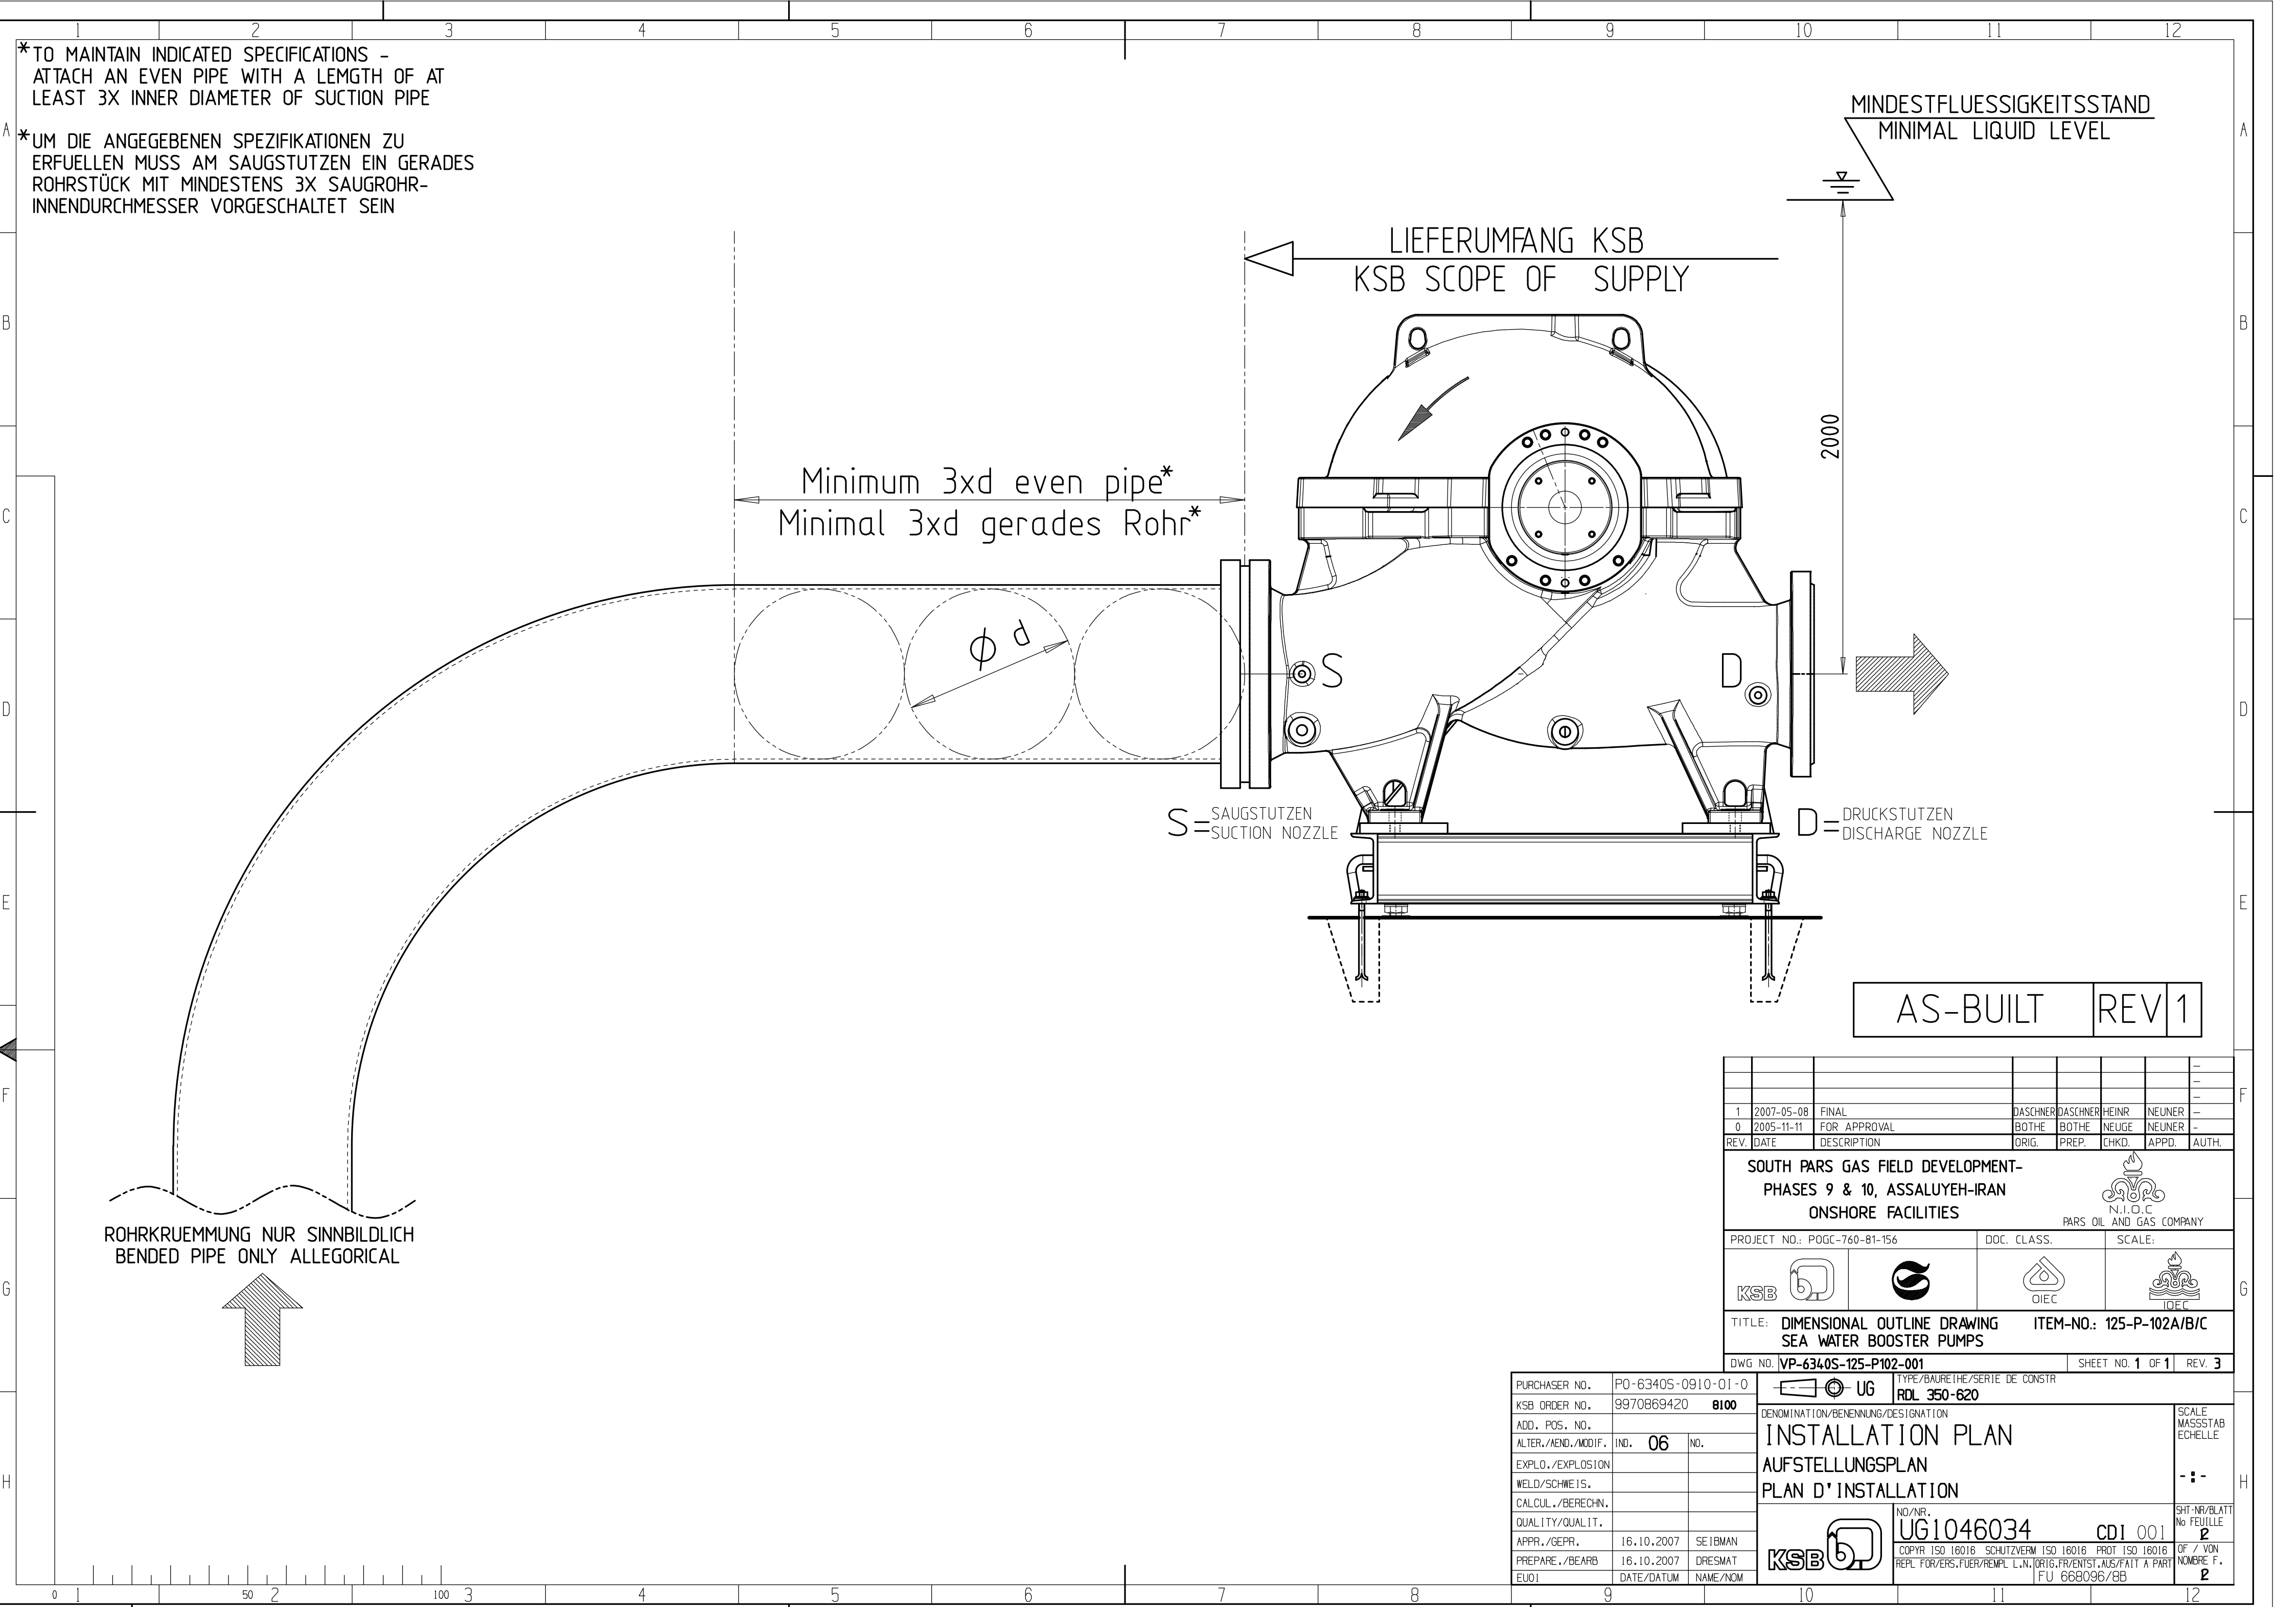



*UM DIE ANGEgebenEN SPEZIFIKATIONEN ZU
ERFUELLEN MUSS AM SAUGSTUTZEN EIN GERADES
ROHRSTÜCK MIT MINDESTENS 3X SAUGROHR-
INNENDURCHMESSER VORGESCHALTET SEIN

Minimum 3xd even pipe*
Minimal 3xd gerades Rohr*

S= SAUGSTUTZEN
SUCTION NOZZLE

D= DRUCKSTUTZEN
DISCHARGE NOZZLE

AS-BUILT REV 1

1	2007-05-08	FINAL	DASCHNER	DASCHNER	HEINR	NEUNER		
0	2005-11-11	FOR APPROVAL	BOTHE	BOTHE	NEUGE	NEUNER		
REV.	DATE	DESCRIPTION	ORIG.	PREP.	CHKD.	APPD.		AUTH.
<div><div><div>SOUTH PARS GAS FIELD DEVELOPMENT- PHASES 9 & 10, ASSALUYEH-IRAN ONSHORE FACILITIES</div><div><div><div>N.I.O.C PARS OIL & GAS COMPANY</div></div></div></div></div>								
PROJECT NO.: POGC-760-81-156			DOC. CLASS.			SCALE:		
<div></div>				 <div>OIEC</div>		 <div>IOEC</div>		
TITLE: DIMENSIONAL OUTLINE DRAWING SEA WATER BOOSTER PUMPS				ITEM-NO.: 125-P-102A/B/C				
DWG NO. VP-6340S-125-P102-001				SHEET NO. 1 OF 1			REV. 3	

PURCHASER NO.	P0-6340S-0910-01-0	UG	TYPE/BAUREIHE/SERIE DE CONSTR	RDL 350-620
KSB ORDER NO.	9970869420	8100	DENOMINATION/BENENNUNG/DESIGNATION	
ADD. POS. NO.			INSTALLATION PLAN	
ALTER./END./MODIF.	IND. 06	NO.	AUFSTELLUNGSPLAN	
EXPLO./EXPLOSION			PLAN D'INSTALLATION	
WELD/SCHWEIS.			SCALE	
CALCUL./BERECHN.			MASSSTAB	
QUALITY/QUALIT.			ECHELLE	
APPR./GEPR.	16.10.2007	SEIBMAN	NO/NR.	
PREPARE./BEARB.	16.10.2007	DRESMAT	UG1046034	
EU01	DATE/DATUM	NAME/NOM	CDI 001	
			SHT-NR/BLATT	
			No FEUILLE	
			2	
			OF / VON	
			NOMBRE F.	
			2	
			REPL. FOR/VERS./FUEH/REMP. L.N./ORIG./FR/ENTST./AUS/FAIT A PART	
			FU 668096/8B	