
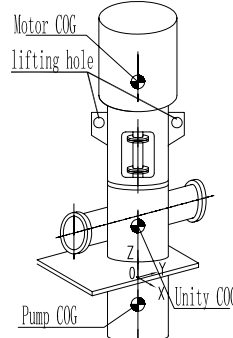


REFERENCE DRAWING	DWG. NO.
MOTOR OUTLINE DRAWING	NGL-V-2014-ME-DW-2018
COUPLING DRAWING	NGL-V-2014-ME-DW-2016
PUMP DATA SHEET	NGL-V-2014-ME-DT-2003
PUMP CROSSSECTION DRAWING	NGL-V-2014-ME-DW-2005
PUMP P&ID	NGL-V-2014-ME-PD-2006
Seal System Drawing and BOM	NGL-V-2014-ME-DW-2013

PUMP INFORMATION	
Item No.:	P-3181-01 A/B/S
Service:	Treated Steam Condensate Pump
Model:	LDB 160A-18.5x3-BA
Seal Plan:	23+61
Flow/Head	114.1m ³ /h & 50m
Motor:	30KW - 4P
Rotation:	Anti-clockwise viewed from the drive-end
No of Stages:	3
Pump Speed:	1470 rpm

Code1	<input type="checkbox"/> (Approved): No comment and release for Manufacturing (Document to be stamped as Final for considering in Vendor Data Book)
Code2	<input type="checkbox"/> (Approved with Comments): VENDOR/Sub-Contractor shall correct/revise document and issue it as "FOR APPROVAL" (Work May Be Proceeded)
Code3	<input type="checkbox"/> (Commented): VENDOR/Sub-Contractor shall correct /revise and resubmit it as "FOR APPROVAL" of the date documents specified (Corrected to be resubmitted before starting to manufacture.
No Code	<input type="checkbox"/> CONSULTANT and PURCHASER check results on Class 2 documents will be returned without any CODE. VENDOR/Sub-Contractor shall correct/revise document and issue it as "FOR INFORMATION"
The above checking result by OIEC shall in no way relieve Vendor of any liability, obligation and responsibility out of the purchase order and the mutual agreement in writing	
<div><div>DATE : DEPT: Signature :</div></div>	


Maximum Allowable Amplitude For Foundation	
Velocity (Peak)	4 mm/s
Displacement	25.4 μm


LIFTING INFORMATION	
	Pump COG
	AY 0
	AZ 330
Motor COG	BX 0
	BY 0
	BZ 500
Unity COG	CX 0
	CY 0
	CZ 20
COG	

Static loading calculation results			Dynamic loading calculation results		
FXstatic=	10400/10400 N		FXdynamic=	115/115 N	
FYstatic=	13340/13340 N		FYdynamic=	115/115 N	
FZstatic=	-25947/43047 N		FZdynamic=	0/0 N	
MXstatic=	18152/18152 N*m		MXdynamic=	14/14 N*m	
MYstatic=	8291/8291 N*m		MYdynamic=	14/14 N*m	
MZstatic=	12100/12100 N*m		MZdynamic=	195/-195 N*m	


Note:
Location of Loads & Moments Calculation is the geometric center of baseplate lower surface.

D3	20.08.15	ISSUED FOR APPROVAL	R.X	T.H	R.C	A.A.
D2	20.07.15	ISSUED FOR APPROVAL	R.X	T.H	R.C	A.A.
D1	20.06.02	ISSUED FOR APPROVAL	R.X	T.H	R.C	A.A.
D0	20.04.30	ISSUED FOR APPROVAL	R.X	T.H	R.C	A.A.
REV.	DATE	DESCRIPTION	PREP	CHECK	APPROVAL	OIEC APP.

Project Title: NGL 3100 PROJECT						
Contractor:  <div>...building trust شرکت مهندسی و ساختمان مسکن هست</div>						
STATUS CODE: A=Comment/Review B=Approval C=Final Issue						
Pump General Arrangement Drawing For Treated Steam Condensate Pump P-3181-01 A/B/S						
OWNER DRAWING NUMBER						
Project Name	Originator	PO Serial No.	Disc.	Doc. Type	Seq No.	Rev.
NGL	V	2014	ME	DW	2002	D3
OIEC DRAWING NUMBER						
Project Code	Source	Unit & Section	Phase	Disc.	Doc. Type	Serial No.
						Rev.


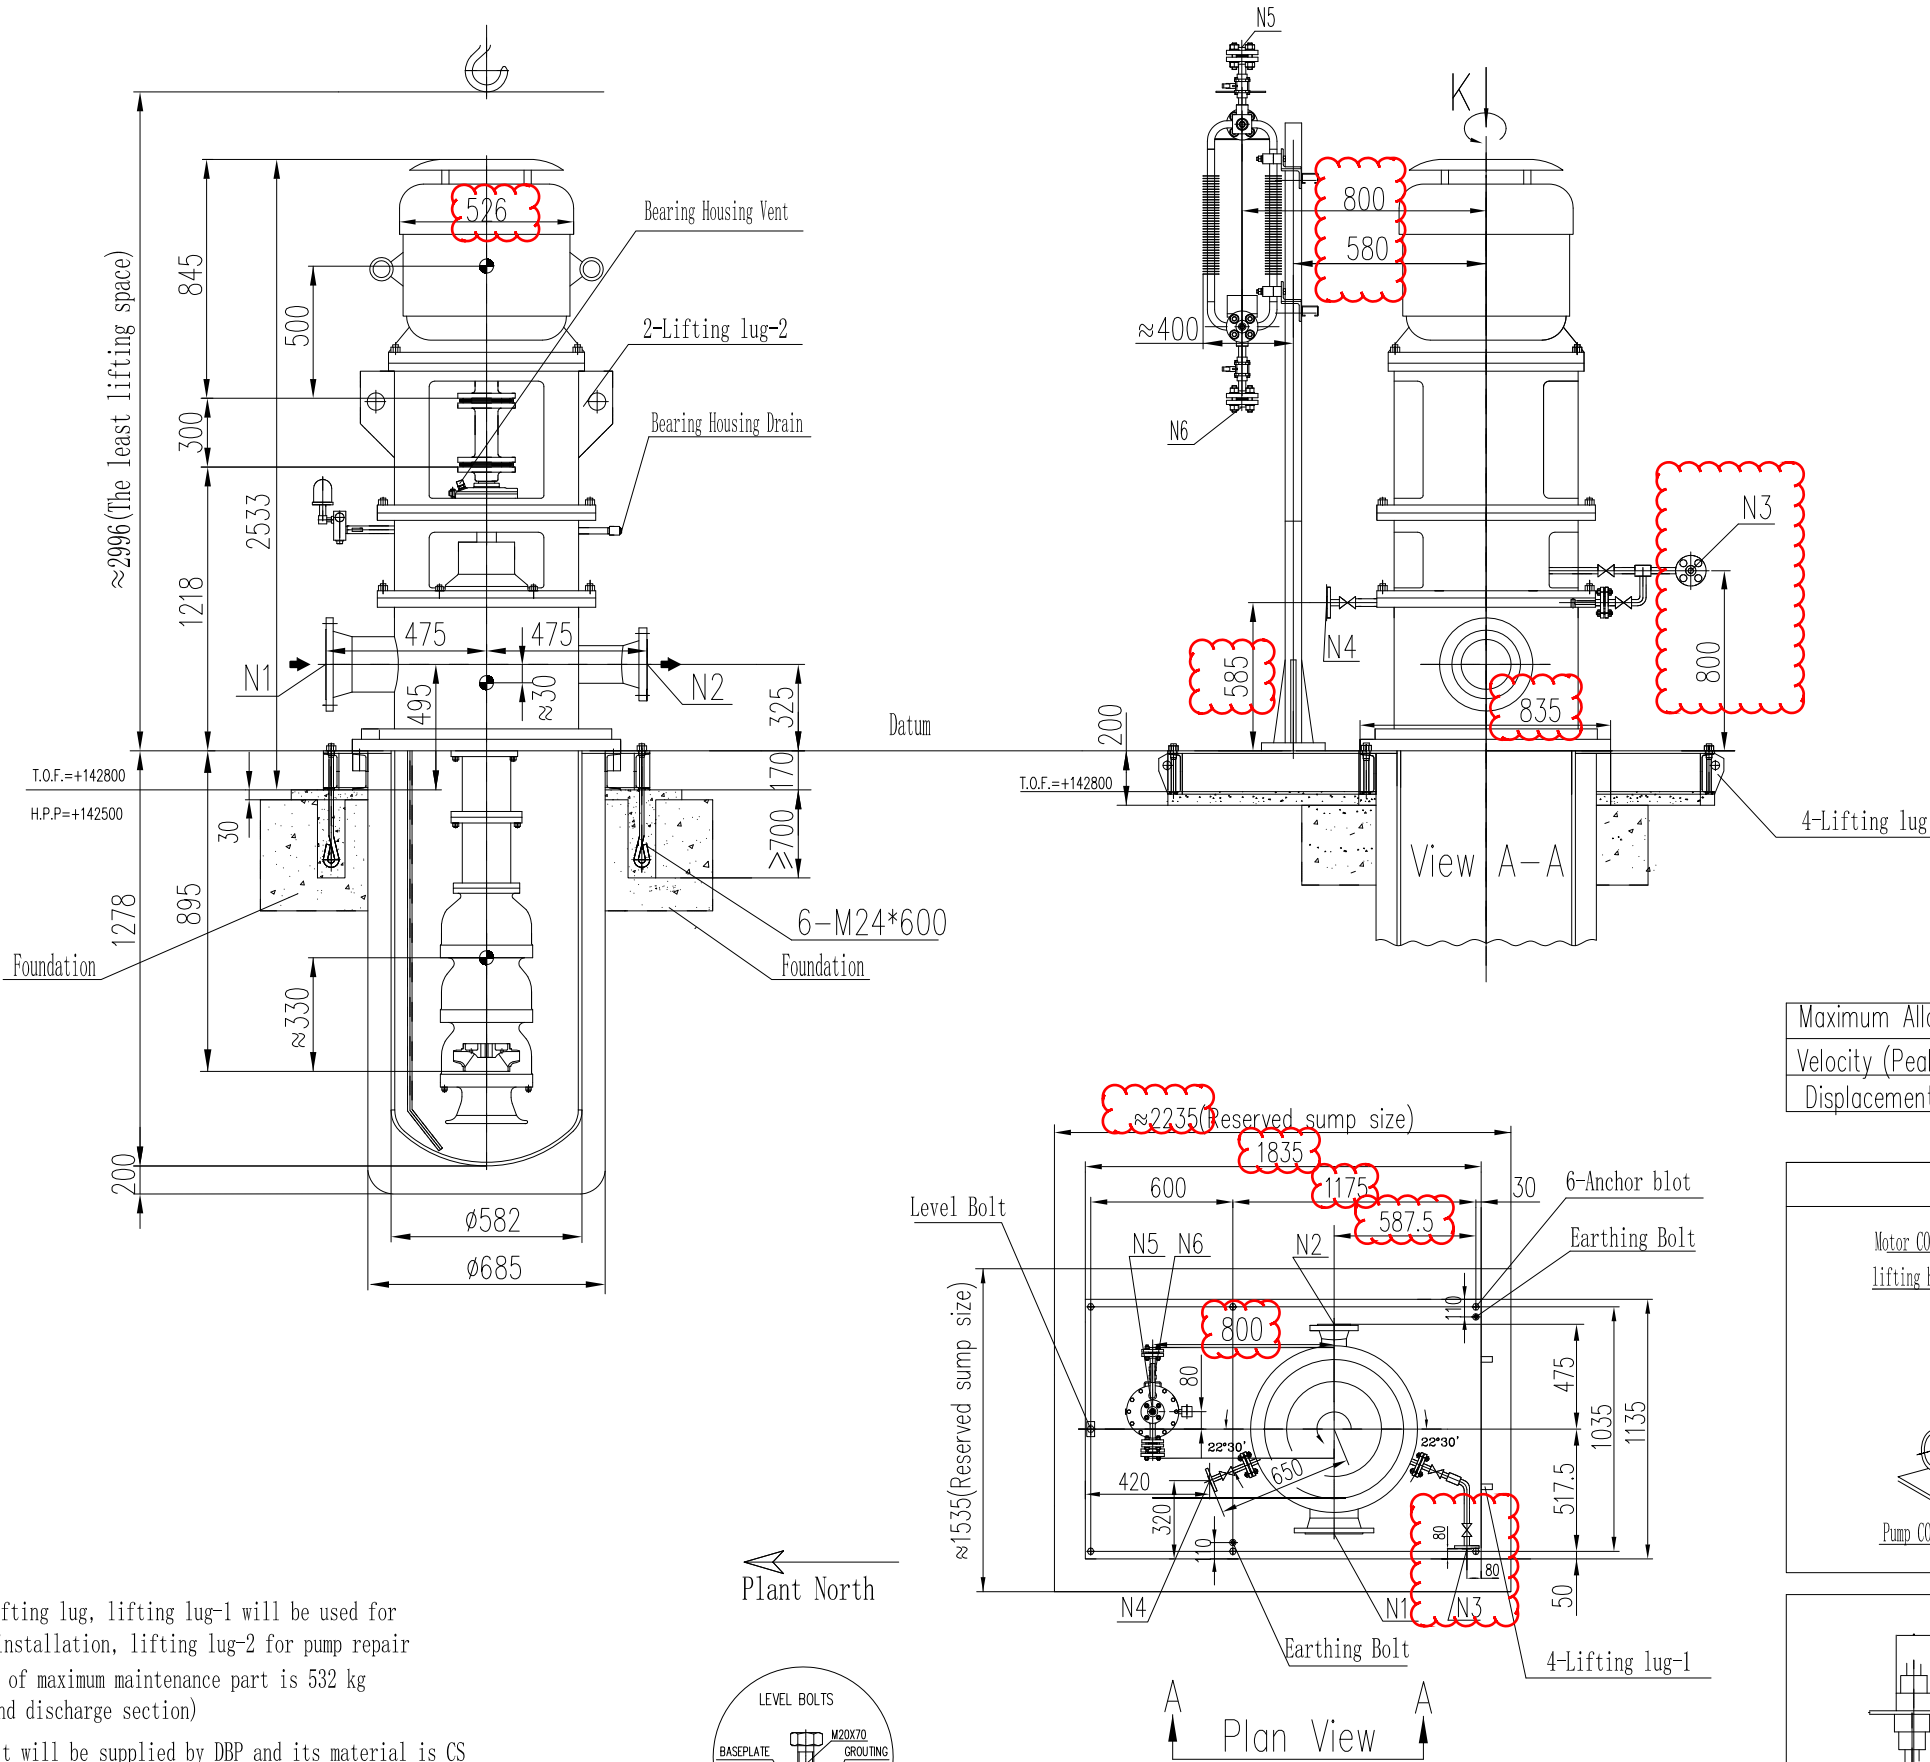


- Note:
- For the lifting lug, lifting lug-1 will be used for the first installation, lifting lug-2 for pump repair
 - The weight of maximum maintenance part is 532 kg (Suction and discharge section)
 - Anchor Bolt will be supplied by DBP and its material is CS
 - Grout material shall be non-shrinkage cement mortar or epoxy mortar.
 - Mass of rotor for all parts is 85 Kg.

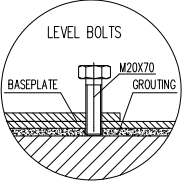

WEIGHT(Kg)	Level and grouting detail	Earthing bolt detail	PUMP END	LIFTING LUG
Total	2699			
Skid weight	90			
Aux. weight	35			
Motor weight	335			
Pump weight	2239			

Nozzle information						
6	Plan 23 Drain	N6	1/2"	ASME B16.5-09	Class600	RF
5	Plan 23 Vent	N5	1/2"	ASME B16.5-09	Class600	RF
4	Barrel Drain	N4	3/4"	ASME B16.5-09	Class300	RF
3	Pump Vent	N3	3/4"	ASME B16.5-09	Class300	RF
2	Pump Discharge	N2	4"	ASME B16.5-09	Class300	RF
1	Pump Suction	N1	8"	ASME B16.5-09	Class300	RF
NO.	Nozzle	Sign	NPS	Standard	Rating	Face

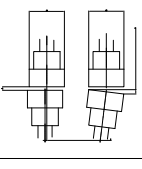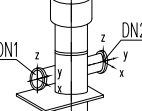	D≤200	X	≤0.05				
		Y	≤0.05				
		Z	Z±0.1				
	200<D≤300	X	≤0.08				
		Y	≤0.08				
		Z	Z±0.15				
	300<D≤400	X	≤0.10				
		Y	≤0.10				
		Z	Z±0.2				
Nozzle load,Force(N)/Moment(N.m)							
	DN1	Fx	7560	Fy	9780	Fz	6220
		Mx	7060	My	3520	Mz	5160
	DN2	Fx	2840	Fy	3560	Fz	2320
		Mx	2660	My	1360	Mz	2000

NGL-CT-1-0000-ME-PO-0014-D0