
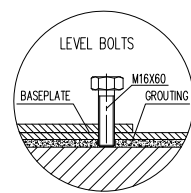
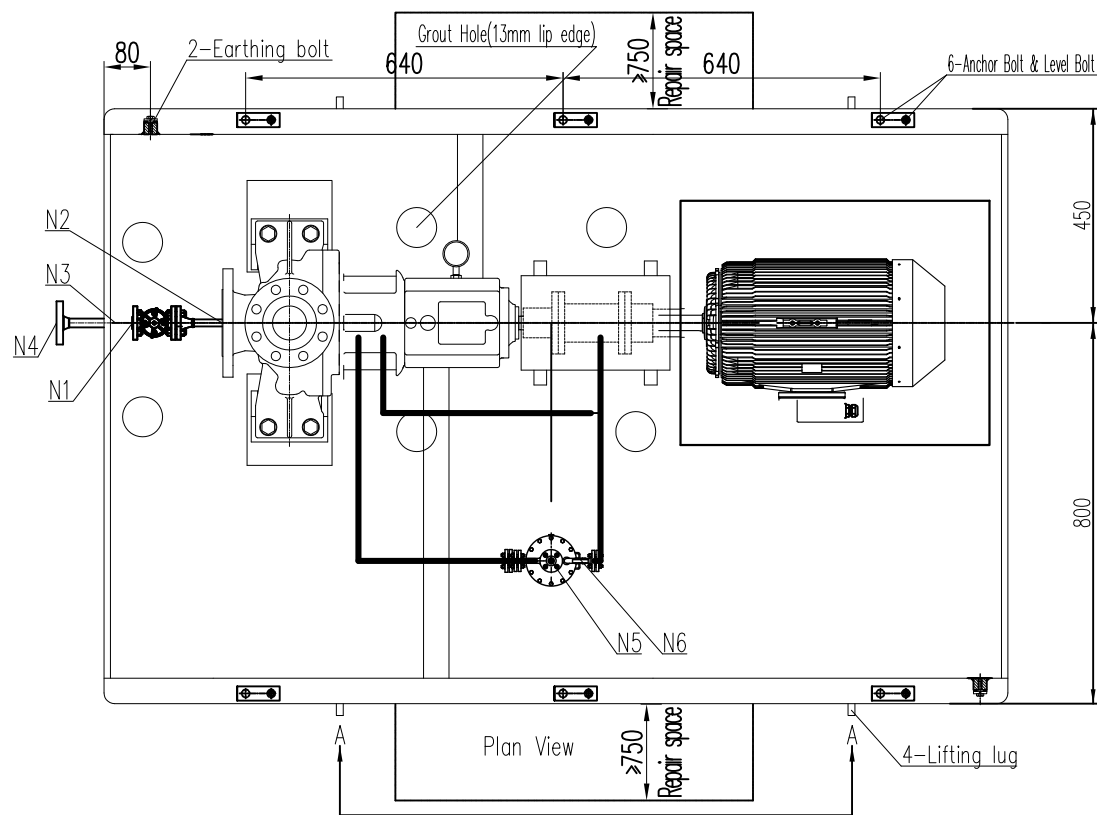


Prevailing wind direction is N 45 ° E
Plant North

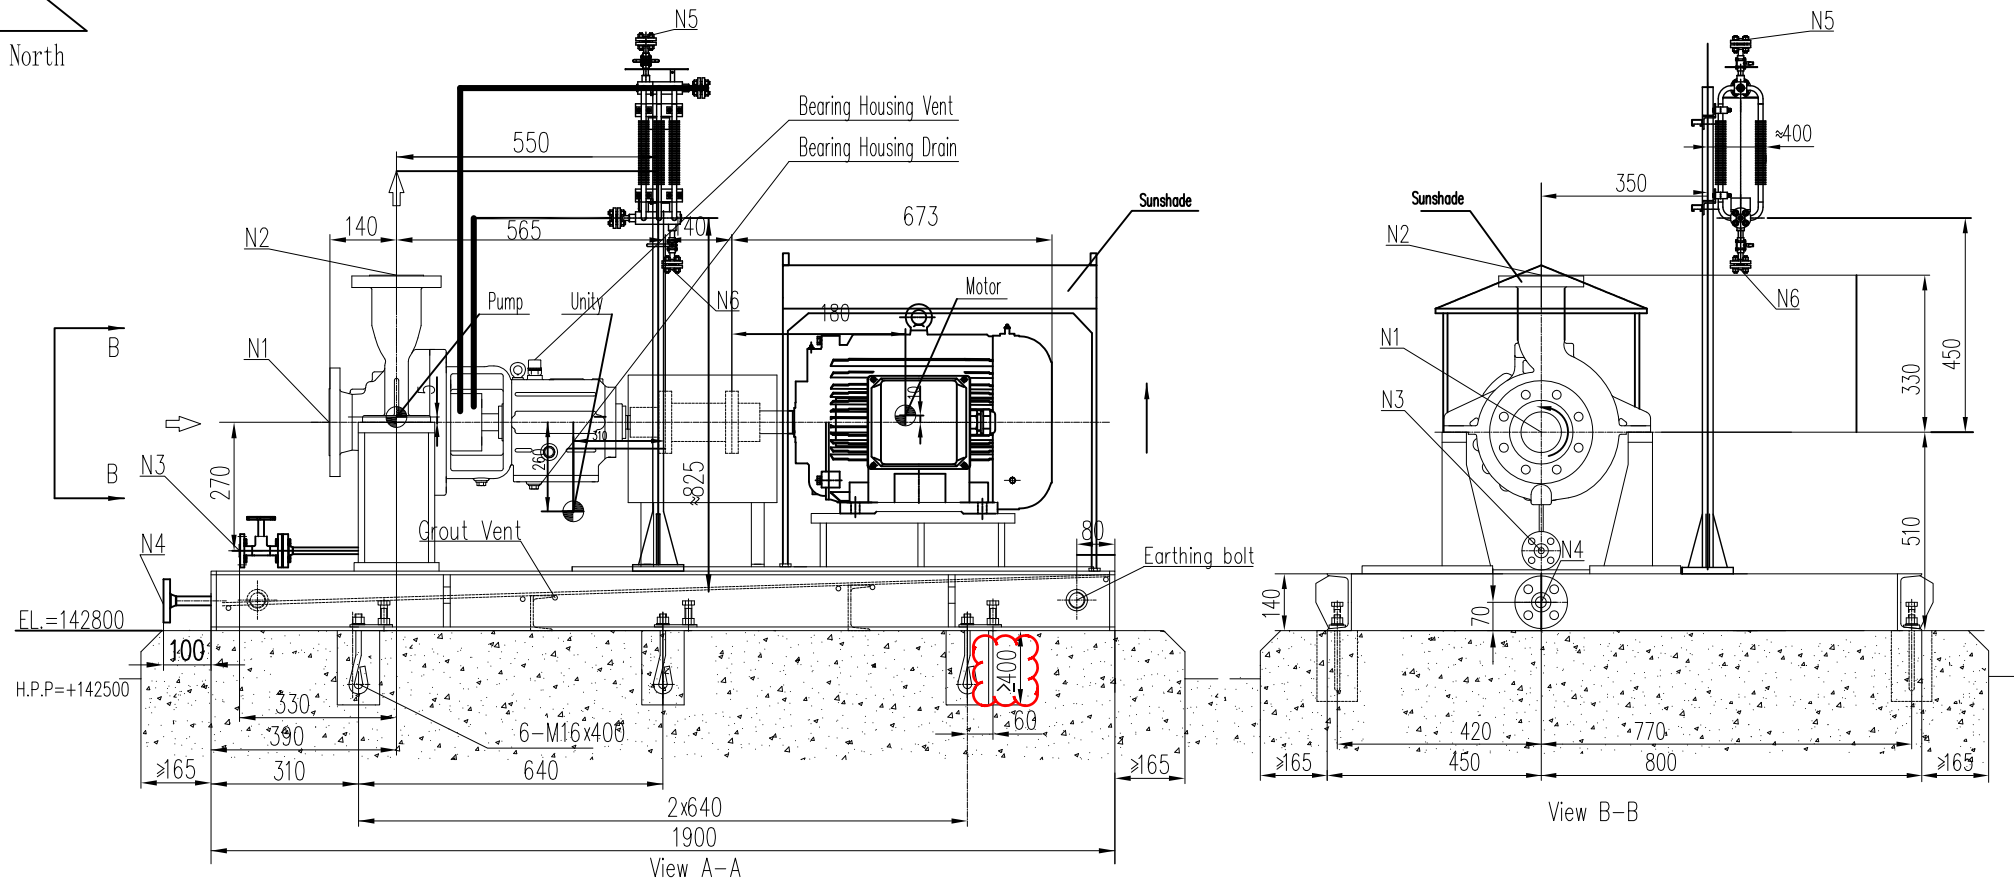


Maximum Allowable Amplitude For Foundation	
Velocity (Peak)	4 mm/s
Displacement	25.4 μm

Nozzle information							
6	Plan 23 drain	N6	1/2"	ASME B16.5-09	Class600	RF	
5	Plan 23 vent	N5	1/2"	ASME B16.5-09	Class600	RF	
4	Baseplate drain	N4	1"	ASME B16.5-09	Class150	RF	
3	Pump drain	N3	3/4"	ASME B16.5-09	Class300	RF	
2	Pump Discharge	N2	1-1/2"	ASME B16.5-09	Class300	RF	
1	Pump Suction	N1	2"	ASME B16.5-09	Class300	RF	
NO.	Nozzle	Sign	NPS	Standard	Rating	Face	

REFERENCE DRAWING	DWG. NO.
MOTOR OUTLINE DRAWING	NGL-V-2014-ME-DW-8018
COUPLING DRAWING	NGL-V-2014-ME-DW-8016
PUMP DATA SHEET	NGL-V-2014-ME-DT-8003
PUMP CROSSSECTION DRAWING	NGL-V-2014-ME-DW-8005
PUMP P&ID	NGL-V-2014-ME-PD-8006
Seal System Drawing and BOM	NGL-V-2014-ME-DW-8013


PUMP INFORMATION	
Item No.:	P-3185-03 A/S
Service:	Steam Condensate Pump
Model:	EAP 40-250B-35-XA
Seal Plan:	23+61
Flow/Head	2.75m ³ /h & 71m
Motor:	11KW - 2P
Rotation:	Clockwise viewed from the drive-end
No of Stages:	1
Pump speed:	2930 rpm




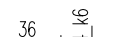
Code1	<input type="checkbox"/> (Approved): No comment and release for Manufacturing (Document to be stamped as Final for considering in Vendor Data Book)
Code2	<input type="checkbox"/> (Approved with Comments): VENDOR/Sub-Contractor shall correct/revise document and issue it as "FOR APPROVAL" (Work May Be Proceeded)
Code3	<input type="checkbox"/> (Commented): VENDOR/Sub-Contractor shall correct /revise and resubmit it as "FOR APPROVAL" of the date documents specified (Corrected to be resubmitted before starting to manufacture.
No Code	<input type="checkbox"/> CONSULTANT and PURCHASER check results on Class 2 documents will be returned without any CODE. VENDOR/Sub-Contractor shall correct/revise document and issue it as "FOR INFORMATION"
The above checking result by OIEC shall in no way relieve Vendor of any liability, obligation and responsibility out of the purchase order and the mutual agreement in writing	
<div> OIEC ...building trust شرکت مهندسی و ساختمان مستقیم فست</div> <div>DATE : DEPT: Signature :</div>	

Static loading calculation results				Dynamic loading calculation results			
FXstatic=	3200/3200	N		FXdynamic=	0/0	N	
FYstatic=	2580/2580	N		FYdynamic=	0/0	N	
FZstatic=	-2848/8728	N		FZdynamic=	0/0	N	
MXstatic=	3539/3539	N*m		MXdynamic=	2101/-2101	N*m	
MYstatic=	5129/4589	N*m		MYdynamic=	0/0	N*m	
MZstatic=	3069/3069	N*m		MZdynamic=	0/0	N*m	

Note:
Location of Loads & Moments Calculation is the geometric center of baseplate lower surface.

D3	20.08.13	ISSUED FOR APPROVAL	R.X	T.H	R.C	A.A.
D2	20.07.15	ISSUED FOR APPROVAL	R.X	T.H	R.C	A.A.
D1	20.06.02	ISSUED FOR APPROVAL	R.X	T.H	R.C	A.A.
D0	20.04.30	ISSUED FOR APPROVAL	R.X	T.H	R.C	A.A.
REV.	DATE	DESCRIPTION	PREP	CHECK	APPROVAL	OIEC APP.

Project Title:										NGL 3100 PROJECT																													
Contractor:																				<div> OIEC ...building trust شرکت مهندسی و ساختمان صنایع نفت</div>																			
STATUS CODE: A=Comment/Review B=Approval C=Final Issue																				Pump General Arrangement Drawing For Steam Condensate Pump P-3185-03 A/S																			
OWNER DRAWING NUMBER																				NGL-CT-1-0000-ME-PO-0014-D0																			
Project Name					Originator			PO Serial No.			Disc.		Doc. Type		Seq No.		Rev.		Sheet No.			Status		Class		Size													
NGL					V			2014			ME		DW		8002		D3		1 OF 1			B		1		A3													
OIEC DRAWING NUMBER																																							
Project Code					Source			Unit & Section					Phase					Disc.		Doc. Type			Serial No.					Rev.											

WEIGHT(Kg)		Anchor Bolt Detail	Earthing bolt detail	PUMP END	LIFTING LUG
Total	640				
Skid weight	300				
Aux. weight	70				
Motor weight	105				
Pump weight	165				