


LEITUNGEN SPANNUNGSFREI ANSCHLIESSEN!
ZULÄSSIGE MASSABWEICHUNGEN FÜR:
ACHSHÖHEN FÜR MASCHINEN
ANSCHLUSSMASSE FÜR PUMPEN
MASSE OHNE TOLERANZANGABE - GRAUGUSSTEILE
MASSE OHNE TOLERANZANGABE - SCHWEISSTEILE
ALLGEMEINTOLERANZEN FÜR BEARBEITETE TEILE

DIN 747
DIN EN 735
DIN 1686 G7B10
EN ISO 13924B
DIN ISO 2768-M

THE LINES MUST BE CONNECTED WITHOUT TRANSMITTING ANY STRESSES OR STRAIN!
PERMISSIBLE DEVIATIONS OF DIMENSIONS FOR:
AXIS HEIGHTS FOR MACHINES
CONNECTION DIMENSIONS FOR PUMPS
DIMENSIONS WITHOUT MENTION OF TOLERANCES - GREY CAST IRON COMPONENTS
DIMENSIONS WITHOUT MENTION OF TOLERANCES - WELDED COMPONENTS
GENERAL TOLERANCES FOR MACHINED COMPONENTS


DIN 747
DIN EN 735
DIN 1686 G7B10
EN ISO 13924B
DIN ISO 2768-M

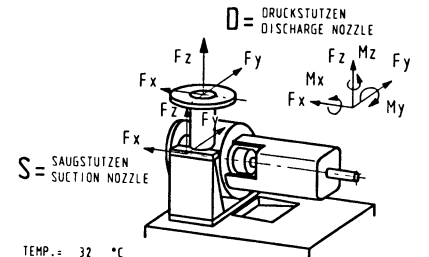

TEMP.: 32 °C
ZULÄSSIGE KRAEFTE UND MOMENTE ENTSPRECHEN MIN. 2X API 610/8.
DIE ANGABEN GELTEN FÜR STATISCHE ROHRLEITUNGSLASTEN.
BEI ÜBERSCHREITUNG IST NACHPRÜFUNG ERFORDERLICH.
ADMISSIBLE FORCES AND MOMENTS CORRESPOND TO MIN. 2X API 610/8.
DATA GIVEN BELOW ARE ONLY VALID FOR STATIC PIPING LOADS.
IF VALUES ARE EXCEEDED CHECK IS NECESSARY.

KRAEFTE, MOMENTE / FORCES, MOMENTS

KRAEFTE FORCES (N)	SAUGSTUTZEN SUCTION NOZZLE				DRUCKSTUTZEN DISCHARGE NOZZLE			
	Fx	Fz	Fy	Fres	Fx	Fz	Fy	Fres
3560	2320	2840	5110	2140	2670	1780	3860	
MOMENTE MOMENTS (Nm)	Mx	Mz	My	Mres	Mx	Mz	My	Mres
	2660	2010	1360	3600	1900	1440	950	2570

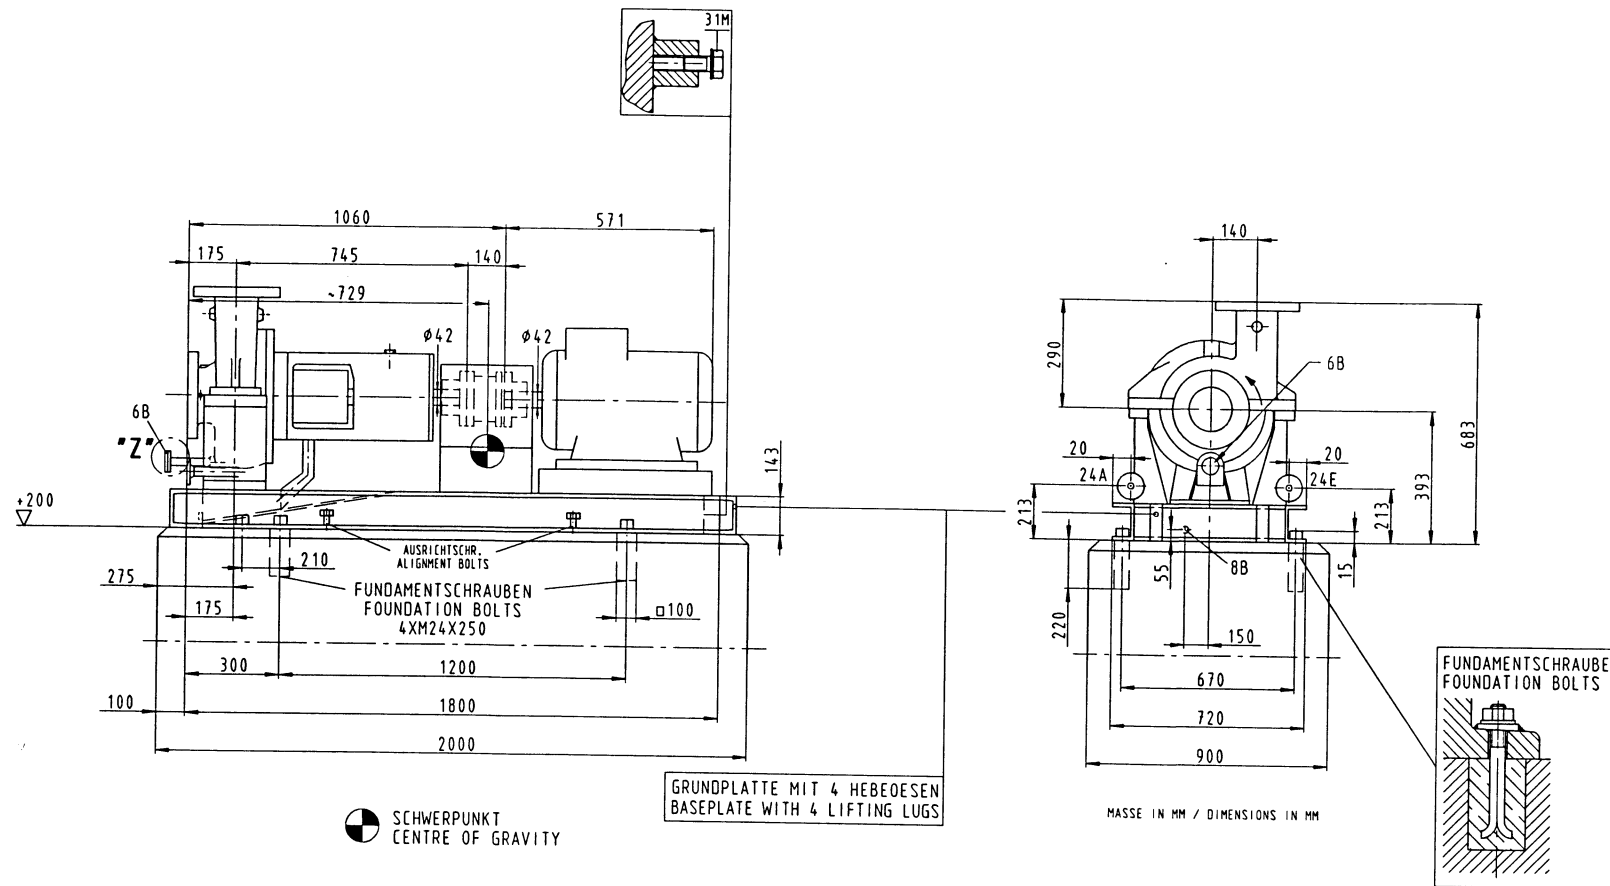

Revision for previous editions only

☐ A No comments / remarks may be present

☐ B Comments (remarks) must be present / subject to transmission of

☐ C Comments (remarks) must be present / subject to transmission of

☐ D Comments (remarks) must be present / subject to transmission of

☐ E Comments (remarks) must be present / subject to transmission of

☐ F Comments (remarks) must be present / subject to transmission of

☐ G Comments (remarks) must be present / subject to transmission of

☐ H Comments (remarks) must be present / subject to transmission of

☐ I Comments (remarks) must be present / subject to transmission of

☐ J Comments (remarks) must be present / subject to transmission of

☐ K Comments (remarks) must be present / subject to transmission of

☐ L Comments (remarks) must be present / subject to transmission of

☐ Y Comments (remarks) must be present / subject to transmission of

☐ Z Comments (remarks) must be present / subject to transmission of


Signature: _____ Date: _____

24E/24A	NPS1/2"	QUENCHFLÜSSIGKEIT EIN/AUS - QUENCH LIQUID INLET/OUTLET	-	-	X	S	-0.5	-
31M	M10	ERDUNGSANSCHLUSS - EARTHING CONNECTION	-	X	-	-	-	-
24B	NPT 1/2	QUENCHFLÜSSIGKEIT ABLAUSS - QUENCH LIQUID DRAIN	X	-	-	-	-	-
24E.2/24A.2	NPT 1/2	QUENCHFLÜSSIGKEIT EIN/AUS - QUENCH LIQUID INLET/OUTLET	X	-	-	-	-	-
12E.1/12A.1	NPT 1/2	ZIRKULATIONSFL. EIN/AUS - CIRCULATION LIQUID INLET/OUTLET	-	-	X	-	-	-
8B.1	NPT 1	LECKABLAUSS - LEAKAGE DRAIN	-	-	X	-	-	-
8B	NPT 1	LECKABLAUSS GRUNDOPLATTE - LEAKAGE DRAIN BASEPLATE	-	X	-	-	-	-
6B	NPS1"	GEHÄUSEABLAUSS - CASING DRAIN	BLIND FLANGE	-	-	-	-	-
13B	NPT 1/2	ÖLABLAUSS - OIL DRAIN	X	-	-	-	-	-
13D	NPT 1/2	ENTLUEFTUNGSSTOPFEN - VENT PLUG	X	-	-	-	-	-
63B	NPT 1/4	ÖLSTANDSREGLER - CONSTANT LEVEL OILER	WIRD LOSE MITGELIEFERT - LOOSE ITEM	-	-	-	-	-
ANSCHLUSS CONNECTION	GROSSE SIZE	BEZEICHNUNG DESIGNATION GEWINDE NACH DIN ISO 228, TEIL 1 UND ISO 7/1 (ENTSPRICHT DIN 2999 TEIL 1) / THREAD ACC. TO DIN ISO 228, PART 1 AND ISO 7/1 (CONFORMING TO DIN 2999, PART 1)	MIT STOPFEN VERSCHLOSSEN/ CLOSED WITH SCREW PLUG	KUNDE/ CUSTOMER	KSB	ERF. MENGE/ QUANTITY REQU. L/MIN	ACTUAL PRESSURE BAR G	DESIGN PRESSURE BAR G
ANSCHLÜSSE / CONNECTIONS DIE AUSFÜHRUNG DES AUFTRAGES IST DURCH X GEKENNZEICHNET / THE EXECUTION OF THE ORDER IS MARKED BY X								

24A	ASME B16.5 CL.300RF NPS1/2"	QUENCH OUT FLANGE API PLAN 62
24E	ASME B16.5 CL.300RF NPS1/2"	QUENCH IN FLANGE API PLAN 62
6B	ASME B16.5 CL.300RF NPS1"	PUMP DRAIN FLANGE
DN2	ASME B16.5 CL.300RF NPS3"	PUMP DISCHARGE FLANGE
DN1	ASME B16.5 CL.300RF NPS4"	PUMP SUCTION FLANGE
ANSCHLUSS CONNECTION	AUSFÜHRUNG DESIGN	REMARKS
FLANSCH / FLANGES		

GRUNDOPLATTENGROSSE BASEPLATE SIZE	ZN24259-9S
MOTORGROSSE MOTOR SIZE	SCHORCH KA7 160M-AB01G-V 2930RPM 13kW
KUPPLUNGSGROSSE COUPLING SIZE	FLENDER N-EUPEX H 95-140
GROSSEN / SIZES	

PUMPE PUMP	242
GRUNDOPLATTE BASEPLATE	325
KUPPLUNG COUPLING	9
ANTRIEB DRIVE	85
-	-
-	-
GESAMT TOTAL	661
GEWICHTE / WEIGHTS KG	

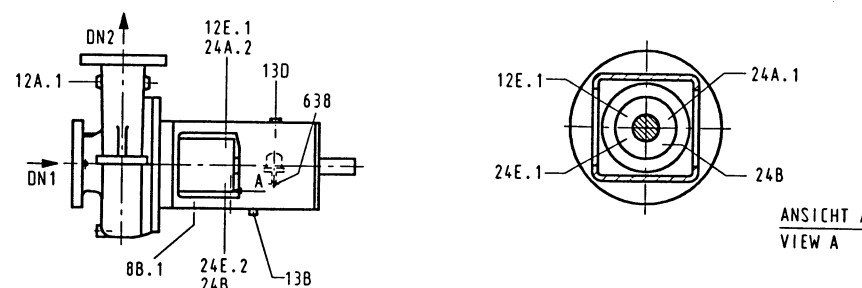

1 2001-10-16 AS BUILT DRESSSEL KOSMAK SCHORCH WALTERS

0 2001-08-01 1ST EDITION DRESSSEL KOSMAK SCHORCH WALTERS

STATUS ISSUE DATE DESCRIPTION PREP. BY CHK. BY APP. BY PROJ. ENGR.

DRAWING TITLE: GENERAL ARRANGEMENT DRAWING FOR CAUSTIC CIRCULATION PUMP ITEM NO.: 10-P-2671 A/B/C

OWNER ENG. NO.: 10-VD-A1-RE-011-033-L P.O. NO.: 2PB434

LINE ENG. NO.: M-ZA 50042 OWNER JOB CODE / PROJ. NO.: PEROL / 70790A PEROL / 70790A

LINE JOB CODE / PROJ. NO.: MARUN / 370 1044

OWNER: NATIONAL PETROCHEMICAL COMPANY MARUN PETROCHEMICAL COMPANY

PROJECT: C2+ RECOVERY AND GAS CRACKING PLANTS

CONTRACTOR: LINDE Engineering and Contracting DIVISION Energy Industrial Engineering and Design

REVISIONS: 2001-10-16 KOSMAK GEPR. 2001-10-16 DRESSSEL 1 2001-08-01 DRESSSEL 0

CAD: 9970089248

PHYSICAL SCALE: RPH 80-180

6-N27-503914/1-3

ITEM-NO.: 10-P-2671 A/B/C

F 103576

BLATT 1 VON 4