


 Energy Industries Engineering & Design Co.	<b>Kangan Utility &amp; Offsite Project</b>		  Kangan Petro Refining Co.
	<b>P.O. No.: KP-80-00-PS-MA-PO-0001-00</b>		
	<b>Document Title:</b> Equipment Outline (D) includig nozzle location for 88-P-3001 A/B		<b>Rev.: 02</b>
	<b>Document No.: VP-80-00-MA-0001-0238</b>		<b>Page 1 of 5</b>

## Equipment Outline (GAD) including nozzle location for 88-P-3001 A/B

<b>Code1</b>	<input type="checkbox"/> <b>Approved</b> No comment and the document is released for Manufacturing.				
<b>Code2</b>	<input type="checkbox"/> <b>Approved with comment</b> Vendor shall correct, revise and resubmit the document. The document can be released for Manufacturing if changes incorporated.				
<b>Code3</b>	<input type="checkbox"/> <b>Commented</b> Vendor shall correct, revise and resubmit the document by the date specified. The document shall be revised under the Status of "R: Revised Issue". All corrected documents shall be resubmitted before starting the Manufacturing.				
<b>Code4</b>	<input type="checkbox"/> <b>Not Accepted (Rejected)</b> Vendor shall re-work/re-design/re-specify the contents of the documents according to the comments/ reasons for rejection. All corrected documents shall be resubmitted before starting the Manufacturing.				
Above checking results by EIED shall in no way relieve Vendor of any liability, obligation and responsibility out of the purchase order and the mutual agreement in writing.					
	<b>Date:</b> <b>Dept:</b> <b>Signature:</b>				
<i>Only for internal review</i>					
<b>CV</b>	<b>PI</b>	<b>EL</b>	<b>IN</b>	<b>ME</b>	<b>MA</b>
<b>ST</b>	<b>AR</b>	<b>PR</b>	<b>SA</b>	<b>HV</b>	<b>TL</b>


02	24-07-18	R	For Approval	F. Toneto	A. Madeira	F. Toneto	A. Madeira
01	18-04-18	R	For Approval	F. Toneto	A. Madeira	F. Toneto	A. Madeira
00	03-07-17	F	For Approval	F. Toneto	A. Madeira	F. Toneto	A. Madeira
<b>Rev.</b>	<b>Date</b>	<b>Status</b>	<b>POI</b>	<b>PRE'D</b>	<b>CHK'D</b>	<b>APR'D</b>	<b>AUZ'D</b>

[illegible]

A triangle with the number 1 inside.

A triangle with the number 1 inside it.

– WARNING / SAFETY SIGN

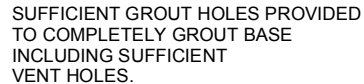


1. **CAUTION! CAREFULLY CHECK ALIGNMENT BEFORE STARTING UNIT. ALL HOLES IN FLANGES STRADDLE CENTERLINES. THE CONNECTION OF PIPES TO THE UNIT HAS TO BE STRESS FREE.**
2. COLORS ARE NOT INTENDED TO REPRESENT "AS SHIPPED" PAINT REQUIREMENTS. THEY ARE FOR QUICK IDENTIFICATION OF PIPING AND EQUIPMENT.
3. PIPING AND EQUIPMENT ARE MODELED REPRESENTATIONS ONLY. ACTUAL LOCATION AND ORIENTATION MAY VARY PER SHIP STANDARDS, UNLESS OTHERWISE DIMENSIONED.
4. THE SUCTION PIPING OR INTAKE DESIGN SHALL MEET THE HYDRAULIC INSTITUTE STANDARDS ANSI/HI 9.8-1998 "PUMP INTAKE DESIGN" REQUIREMENTS.

© SULZER Ltd (2017)  
ALL RIGHTS RESERVED. NO PART OF THIS  
DRAWING MAY BE REPRODUCED, DISTRIBUTED OR  
TRANSMITTED IN ANY FORM OR BY ANY MEANS,  
ELECTRONIC OR MECHANICAL, INCLUDING  
PHOTOCOPYING AND RECORDING, WITHOUT THE  
EXPRESS **PRIOR** WRITTEN CONSENT OF SULZER  
PUMPS






1



A triangle with the number 1 inside.


**CERTIFIED FINAL**


Code1	<input type="checkbox"/> <b>Approved:</b> No comment and the document is released for Manufacturing.
Code2	<input type="checkbox"/> <b>Approved with comment:</b> Vendor shall correct, revise and resubmit the document. "No document can be released for Manufacturing if design is rejected"
Code3	<input type="checkbox"/> <b>Commented:</b> Vendor shall correct, revise and resubmit the document to the site specified. "No document can be released under the Status of "To be tested issue". All comment documents can be resubmitted later during the Manufacturing.
Code4	<input type="checkbox"/> <b>Not Accepted (Rejected):</b> Vendor shall re-work/re-design/re-specify the contents/ contents of the documents according to the comments/ reasons for rejection. All comment documents can be resubmitted later during the Manufacturing.
Above checking results by EIRD shall in no way relieve Vendor of any liability, obligation and responsibility all of the purchase order and the mutual agreement in writing.	
 <div>             DATE : _____              DEPT. : _____              Signature : _____           </div>	
Only for Internal review	
DY	PI EL IN MC MA
ST	AB PR SA HV TL

<p>Kangan Utility &amp; Offsite Project</p>	 <p>KANGAN PETRO REFINING CO.</p>
<p>P.O. No.: KP-80-10-PS-MA-PO-0001-00</p>	<p>SCALE : 1 : 5</p>

							
DRAWING TITLE: Equipment Outline (GAD) including nozzle location							
DRAWING No.		VP-80-10-MA-0001-0238		SHEET No.		1 OF 3	
						REV. 03	
	Drain dimension updated			03/07/2018		03/07/2018	
				J. LOPEZ		V. SANCHEZ	
REV. MODIFICATION				MODIFIED		APPROVED	
SEP. PARTS LIST:				NO		FORMAT: A1	
REPLACED BY:				-		SUBSTITUTE FOR:	
OHH 1x3x11.5-1  100263244-0080				GENERAL ARRANGEMENT GA ISOMETRIC AND DATA SHEET - GENERAL ARRANGEMENT DRAWING		FIRST ANGLE PROJECTION 	
						ORIGINAL SCALE: 1:5	
						DRAWN: 16-MAY-2017 C.ORTIZ	
						CHECKED: 16-MAY-2017 V.SANCHEZ	
						APPROVED: 16-MAY-2017 R.SANCHEZ	
				PART NO.		EN PGA1002632440080-01	
						1 / 3	

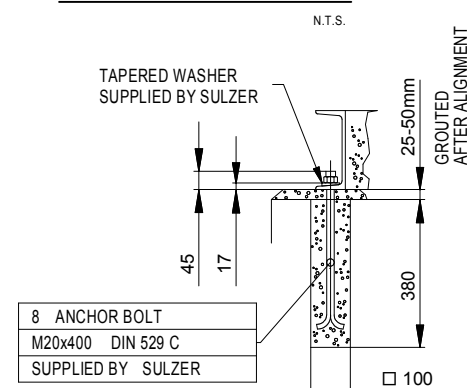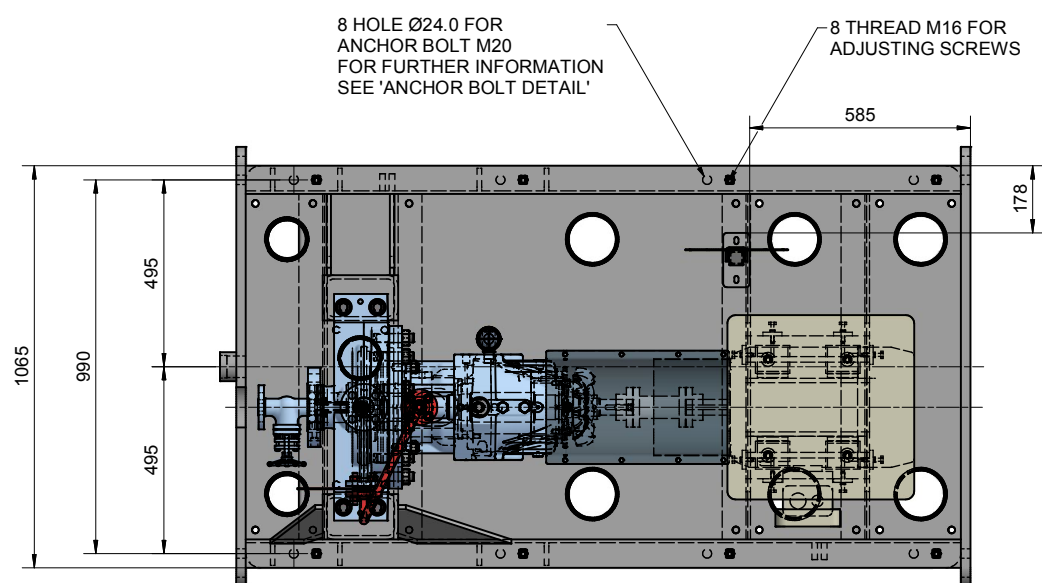


  
 P.N.

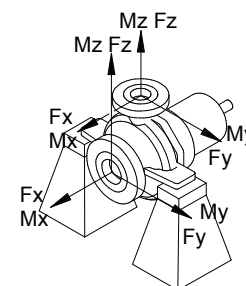

		SUCT	DISCH
FORCES	Fx	2660	1420
	Fy	2140	1160
	Fz	1780	1780
	Fr	3860	2560
MOMENTS	Mx	1900	920
	My	940	460
	Mz	1440	700
	Mr	2560	1240

CONTRACT DATA	
PURCHASER:	Sulzer Pumps Spain SA
USER:	Kangan Petro Refining Co
JOB/PROJECT:	Kangan Utility and Offsite Project
CUST. P.O. NO.:	KP-80-10-PS-MA-PO-0001-00
SERVICE:	Fuel Oil Transfer Pump
INSTALLED AT:	Iran
PUMP OEM:	Sulzer Pumpen (Deutschland) GmbH
SULZER ORDER NO.:	100263244-0080

IDENTIFICATION NUMBERS		
SULZER SERIAL NO.	CUSTOMER TAG NO'S	
	PUMP	DRIVER
588348	88-P-3001 A	88-M-3001 A
588349	88-P-3001 B	88-M-3001 B

<input checked="" type="checkbox"/> CERTIFIED FINAL  <input type="checkbox"/> CERTIFIED FOR NOZZLE & FOUNDATION ONLY  <input type="checkbox"/> PRELIMINARY ONLY	DO NOT SCALE. DIMENSIONS: mm
	<p align="center"><u>UNLESS OTHERWISE SPECIFIED</u></p> <p align="center">TOLERANCES</p> <p align="center">           ≤ 500 mm    ±    3mm            &gt; 500 mm    ±    12mm         </p> <p align="center">AUXILIARY CUSTOMER CONNECTION DIMENSIONS ± 25</p>

03	03.07.18	R	For Approval	JL	VS	RS	CL
02	11.01.18	R	For Approval	JL	VS	RS	CL
01	10.11.17	R	For Approval	JL	VS	RS	CL
00	02.06.17	F	For Approval	JL	VS	RS	CL
Rev.	Date	Status	Purpose of Issue	PRE'D.	CHK'D.	APR'D.	AUZ'D.

Kangan Utility &amp; Offsite Project



KANGAN PETRO REFINING CO

P.O. No.: KP-80-10-PS-MA-PO-0001-00

SCALE : 1:10


# SULZER



DRAWING TITLE:	Equipment Outline (GAD) including nozzle location
----------------	---

DRAWING No.	VP-80-10-MA-0001-0238	SHEET No.	2 OF 3	REV. 03
-------------	-----------------------	-----------	--------	---------

C	Drain dimension updated	03/07/2018	03/07/2018	03/07/2018
		J. LOPEZ	V. SANCHEZ	R. SANCHEZ


REV.	MODIFICATION			MODIFIED	CHECKED	APPROVED
SEP. PARTS LIST:		NO	FORMAT: A1	DESIGN GROUP: -		FIRST ANGLE PROJECTION 
REPLACED BY:		-	SUBSTITUTE FOR:		ORIGINAL SCALE: 1:10	

OHH 1x3x11.5-1	GENERAL ARRANGEMENT FOUNDATION AND NOZZLE	DRAWN: 16-MAY-2017 C.ORTIZ
		CHECKED: 16-MAY-2017

100263244-0080	-	V.SANCHEZ
GENERAL ARRANGEMENT DRAWING		APPROVED: 16-MAY-2017 R.SANCHEZ

<b>SULZER</b>	PART NO.	EN	PGA1002632440080-01	2 / 3
---------------	----------	----	---------------------	-------

© SULZER Ltd (2017)  
ALL RIGHTS RESERVED. NO PART OF THIS  
DRAWING MAY BE REPRODUCED, DISTRIBUTED OR  
TRANSMITTED IN ANY FORM OR BY ANY MEANS,  
ELECTRONIC OR MECHANICAL, INCLUDING  
PHOTOCOPYING AND RECORDING, WITHOUT THE  
EXPRESS **PRIOR** WRITTEN CONSENT OF SULZER  
PUMPS

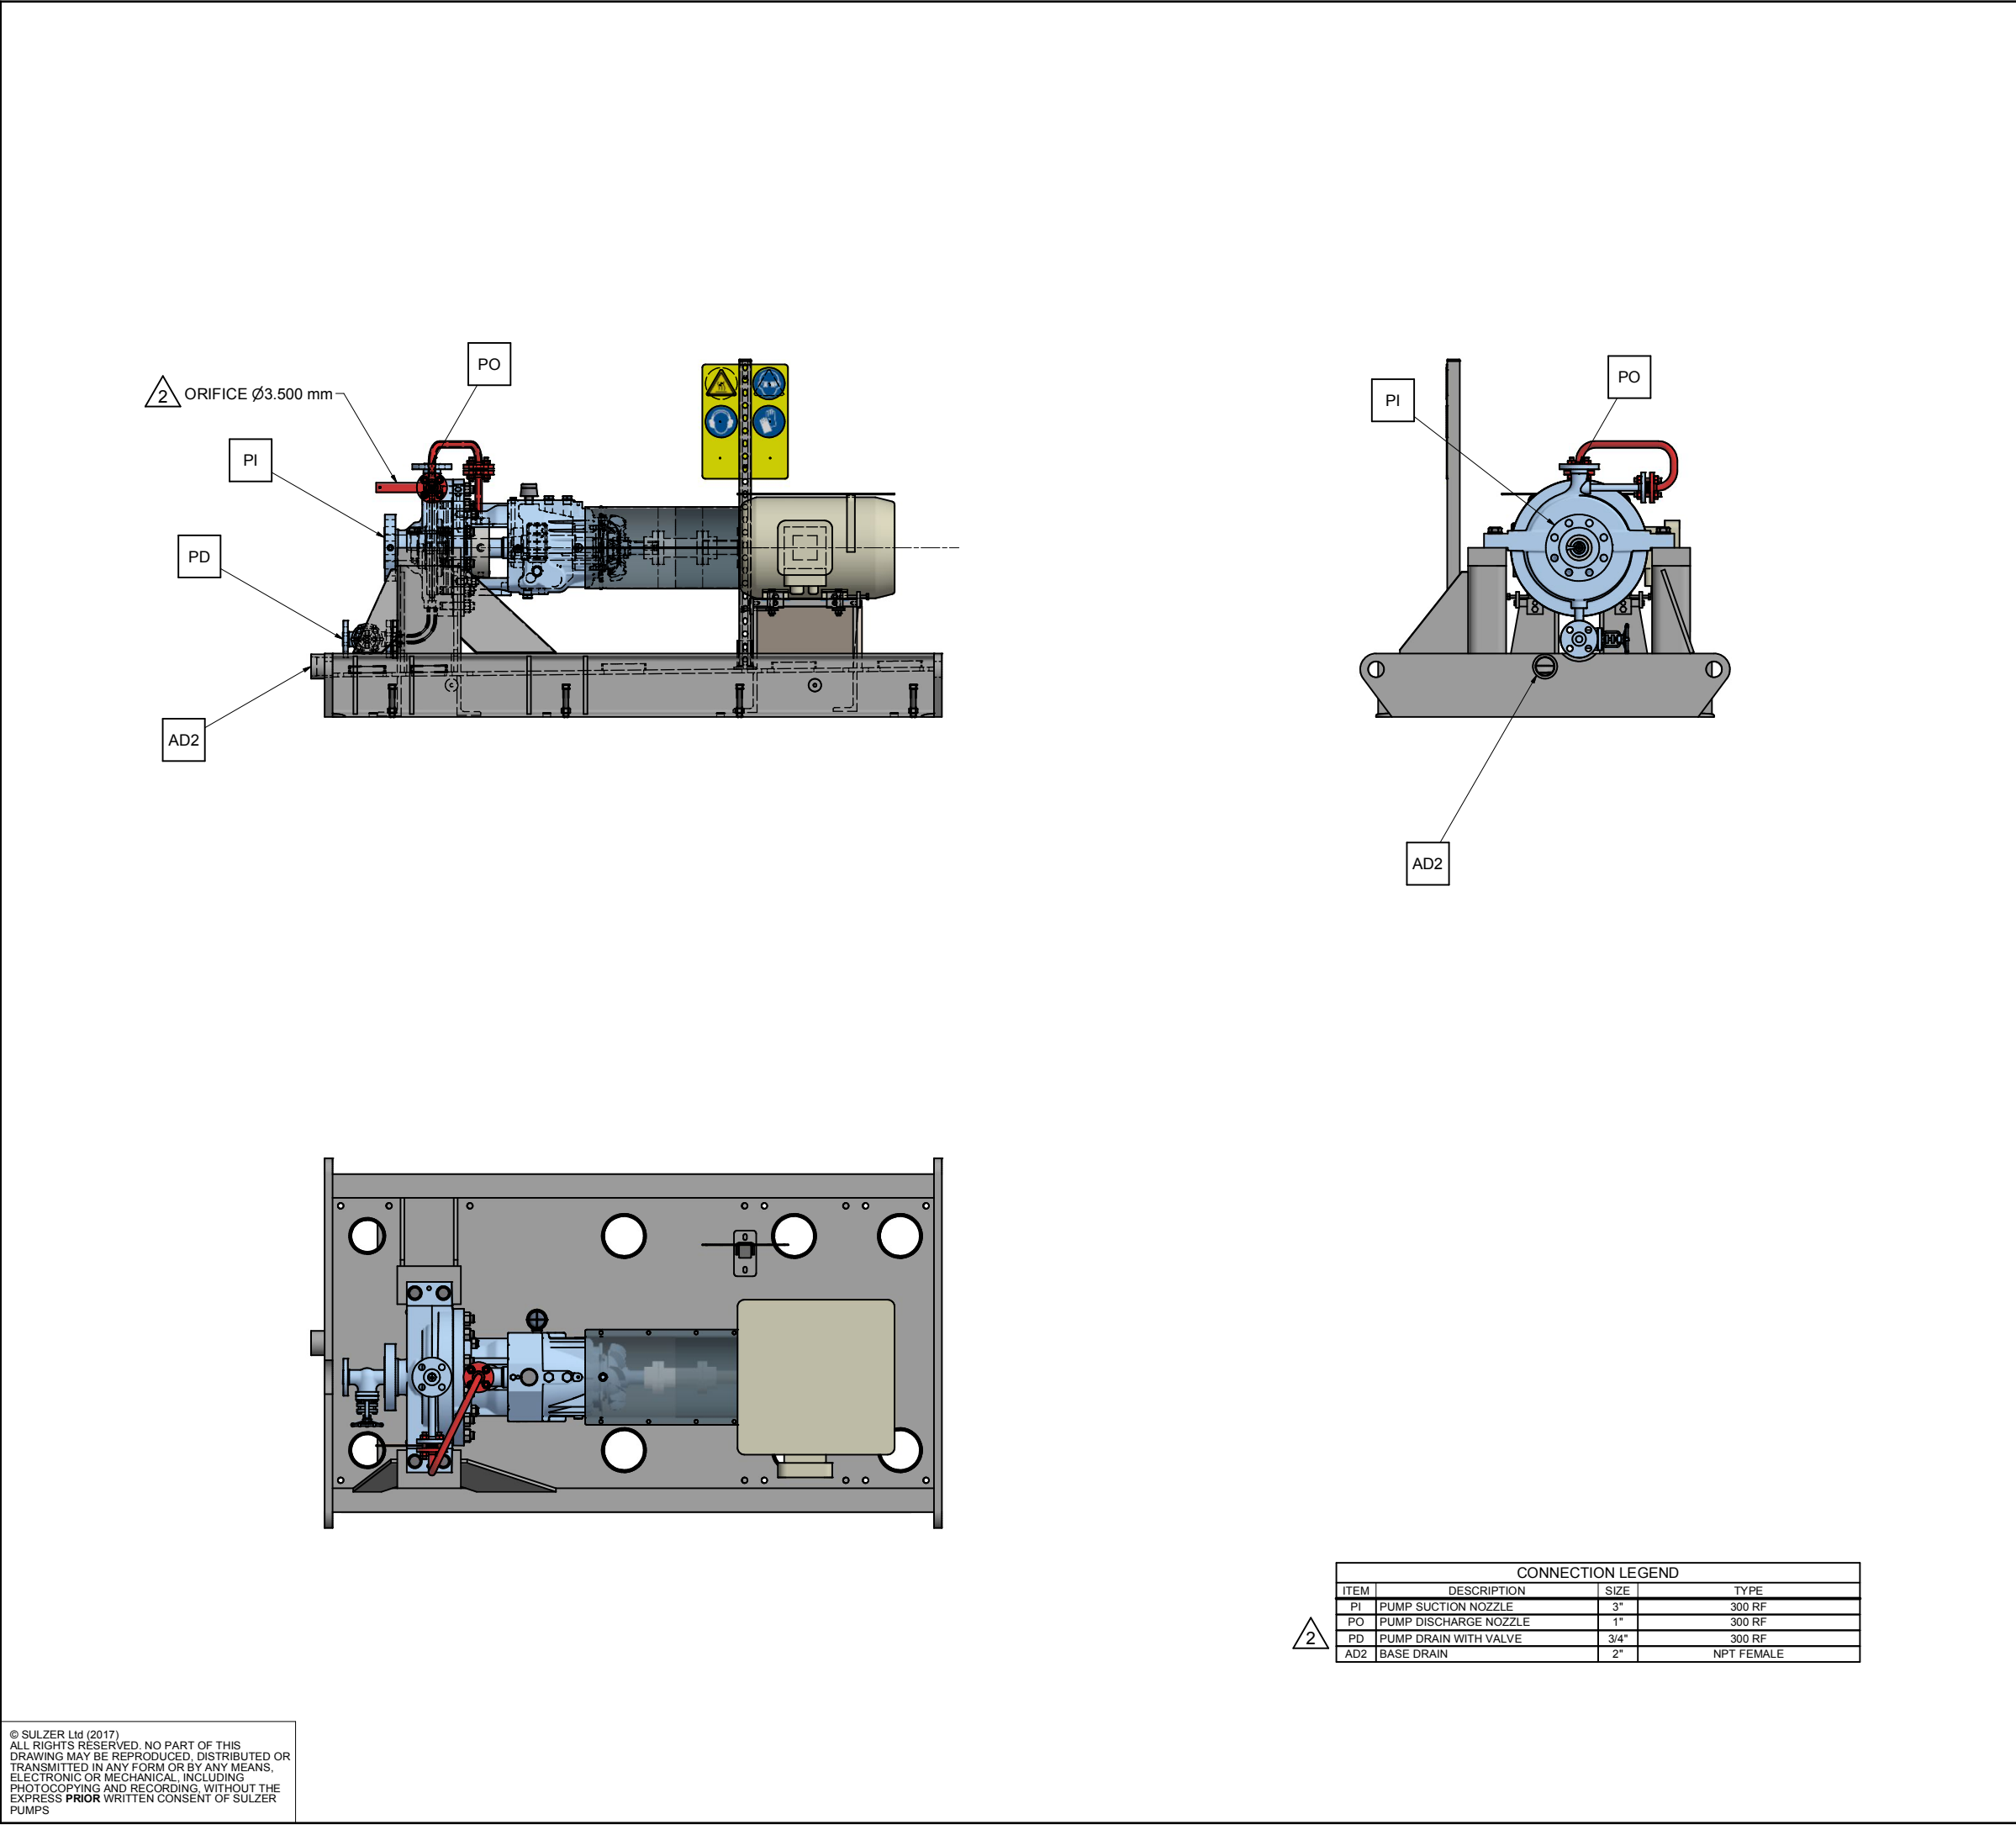

© SULZER Ltd (2017)  
ALL RIGHTS RESERVED. NO PART OF THIS  
DRAWING MAY BE REPRODUCED, DISTRIBUTED OR  
TRANSMITTED IN ANY FORM OR BY ANY MEANS,  
ELECTRONIC OR MECHANICAL, INCLUDING  
PHOTOCOPYING AND RECORDING, WITHOUT THE  
EXPRESS PRIOR WRITTEN CONSENT OF SULZER  
PUMPS

CONTRACT DATA																																															
PURCHASER:		Sulzer Pumps Spain SA																																													
USER:		Kangan Petro Refining Co																																													
JOB/PROJECT:		Kangan Utility and Offsite Project																																													
CUST. P.O. NO.:		KP-80-10-PS-MA-PO-0001-00																																													
SERVICE:		Fuel Oil Transfer Pump																																													
INSTALLED AT:		Iran																																													
PUMP OEM:		Sulzer Pumpen (Deutschland) GmbH																																													
SULZER ORDER NO.:		100263244-0080																																													
IDENTIFICATION NUMBERS																																															
SULZER SERIAL NO.	CUSTOMER TAG NO'S																																														
	PUMP	DRIVER																																													
	588348	88-P-3001 A	88-M-3001 A																																												
588349	88-P-3001 B	88-M-3001 B																																													
<div>1</div> <div>1</div>																																															
<div><div></div> CERTIFIED FINAL</div> <div><div></div> CERTIFIED FOR NOZZLE &amp; FOUNDATION ONLY</div> <div><div></div> PRELIMINARY ONLY</div>		DO NOT SCALE. DIMENSIONS: mm																																													
		UNLESS OTHERWISE SPECIFIED TOLERANCES ≤ 500 mm ± 3mm > 500 mm ± 12mm AUXILIARY CUSTOMER CONNECTION DIMENSIONS ± 25																																													
<table><tr><td>03</td><td>03.07.18</td><td>R</td><td>For Approval</td><td>JL</td><td>VS</td><td>RS</td><td>CL</td></tr><tr><td>02</td><td>11.01.18</td><td>R</td><td>For Approval</td><td>JL</td><td>VS</td><td>RS</td><td>CL</td></tr><tr><td>01</td><td>10.11.17</td><td>R</td><td>For Approval</td><td>JL</td><td>VS</td><td>RS</td><td>CL</td></tr><tr><td>00</td><td>02.06.17</td><td>F</td><td>For Approval</td><td>JL</td><td>VS</td><td>RS</td><td>CL</td></tr><tr><td>Rev.</td><td>Date</td><td>Status</td><td>Purpose of Issue</td><td>PRE'D.</td><td>CHK'D.</td><td>APR'D.</td><td>AUZ'D.</td></tr></table>								03	03.07.18	R	For Approval	JL	VS	RS	CL	02	11.01.18	R	For Approval	JL	VS	RS	CL	01	10.11.17	R	For Approval	JL	VS	RS	CL	00	02.06.17	F	For Approval	JL	VS	RS	CL	Rev.	Date	Status	Purpose of Issue	PRE'D.	CHK'D.	APR'D.	AUZ'D.
03	03.07.18	R	For Approval	JL	VS	RS	CL																																								
02	11.01.18	R	For Approval	JL	VS	RS	CL																																								
01	10.11.17	R	For Approval	JL	VS	RS	CL																																								
00	02.06.17	F	For Approval	JL	VS	RS	CL																																								
Rev.	Date	Status	Purpose of Issue	PRE'D.	CHK'D.	APR'D.	AUZ'D.																																								
Kangan Utility & Offsite Project																																															
P.O. No.: KP-80-10-PS-MA-PO-0001-00						SCALE : 1: 10																																									
SULZER																																															
DRAWING TITLE: Equipment Outline (GAD) including nozzle location																																															
DRAWING No.		VP-80-10-MA-0001-0238		SHEET No.		2 OF 3																																									
REV.		MODIFICATION		MODIFIED		CHECKED																																									
SEP. PARTS LIST:		NO		FORMAT: A1		DESIGN GROUP: -																																									
REPLACED BY:		-		SUBSTITUTE FOR:		ORIGINAL SCALE: 1:10																																									
OHH 1x3x11.5-1		GENERAL ARRANGEMENT CONNECTION LAYOUT				DRAWN: 16-MAY-2017 C.ORTIZ																																									
100263244-0080		GENERAL ARRANGEMENT DRAWING				CHECKED: 16-MAY-2017 V.SANCHEZ																																									
SULZER		PART NO.		EN		PGA1002632440080-01																																									
						3 / 3																																									