



PROCESS CONNECTIONS		
Code	Name	Size & Rating
N1	Pump Section	2" 3000, SF
N2	Pump Discharge	3/4" 3000, SF
N3	External casing arm	3/4" 3000, SF
N4	Pump Vent	3/4" 3000, SF
N5	Pump Bypass Valve	3/4" 3000, SF
N6	Manometer and vent	3/4" 3000, SF
N7	Seal system vent	3/4" 3000, SF
N8	Seal system drain	3/4" 3000, SF
N9	Hy connection	3/4" 3000, SF
N10	Data connection	1/2" Data Fittings

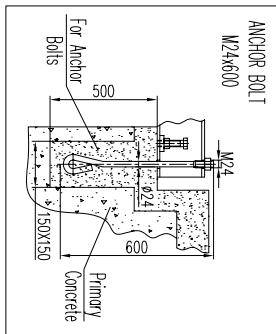

Code	Description
①	Mechanical Seal Vent
②	External Casing Drain
③	Pump Bore Drain
④	Pump Vent
⑤	Barrier Fluid Pipeline (from seal chamber)
⑥	Barrier Fluid Pipeline (to seal chamber)
⑦	PhasesB Drain
⑧	PhasesB Tilt
⑨	PhasesB Vent
⑩	Hy Pipeline


WEIGHT TABLE	
PUMP	1058 KG
WINDOR	100 KG
SEAL SYSTEM	220 KG
WINDING PLATE	80 KG
COUPLING	4 KG
OTHERS	40 KG
TOTAL WEIGHT	1544 KG
ROTORS OF PUMP	80 KG
ROTORS OF WINDOR	80 KG
MAX. VARIANCE WEIGHT	470 KG

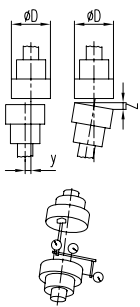

Outer Diameter	Radial Displacement	Axial Tilt
D ≤ 200	< 0.05	< 0.2 / 1000
200 < D ≤ 300	< 0.08	< 0.3 / 1000
300 < D ≤ 400	< 0.1	< 0.4 / 1000




Name	Upper Shaft	Middle Shaft	Middle Shaft	Lower Shaft
Length(mm)	1805	1540	770	838
Quantity	1	1	1	1

Nozzle Allowable Force & Moment			
	N1	N2	
Force (N)			
Fx	±1420	±1780	Fz
Fy	±1420	±1780	Fz
Fz	±1420	±1780	Fz
Moment (N.m)			
Mx	±1420	±1780	Mz
My	±1420	±1780	Mz
Mz	±1420	±1780	Mz

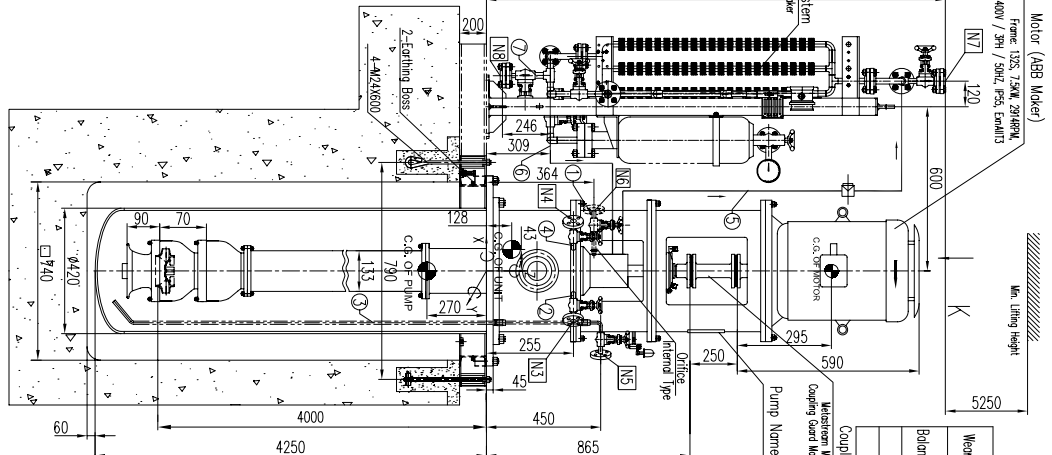

MINIMUM CLEARANCE FOR MAINTENANCE AND DISMANTLING (mm)		
Wear Ring	Second Stage(front)	0.4~0.46
Second Stage(back)	0.35~0.41	
Balance Disc / Balance Sleeve	Axial	0.1~0.15
Shaft Bushing / Shaft Sleeve	Radial	0.35~0.4
Bearing / Cover		0.2~0.26
		0.1~0.2

Center of gravity List			
Item	X	Y	Z
Pump	0	0	-270
Motor	0	0	1400
Units	43	0	128

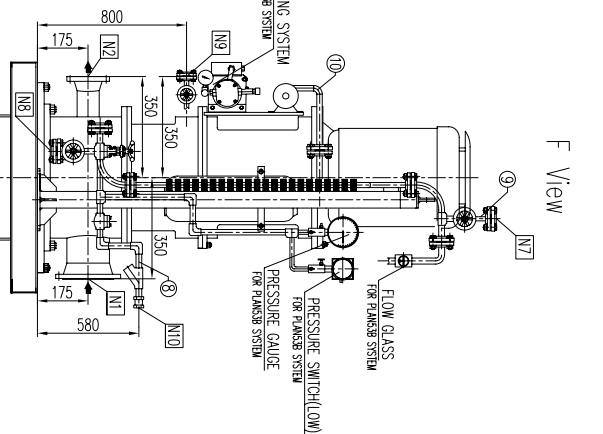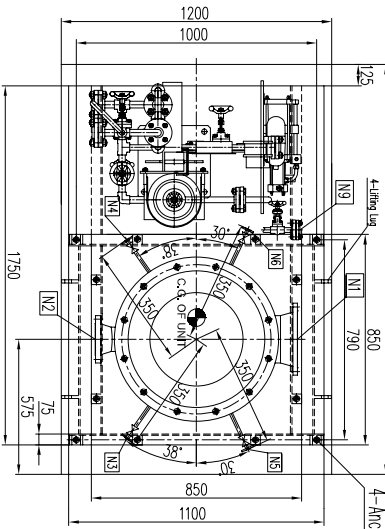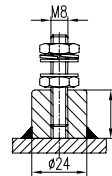

# GENERAL NOTES

PUMP INFORMATION	
Item No.:	145-P-103
Unit:	145
Service:	Propone Truck Unloading Pump
Model:	API610-1B 8.5-25X2
Seal Plan:	53B-H1
Motor:	7.5KW - 2P
Capacity:	10 m <sup>3</sup> /h
Head:	39.9 m

Note: 1. Maximum Allowable Amplitude For Foundation:  
Velocity Peak-Peak: 4 mm/s  
Displacement Peak-Peak: 25.4 μm  
2. Cable gland: 20x32  
3. Cable cores: 3X10 mm<sup>2</sup>  
4. Max. allowable working pressure: 40 barg  
5. For lifting position, Deep Blue suggest:  
1. through the bottom of suction-discharge nozzle,  
2. through the motor frame.

REFERENCE DRAWINGS	DWG. NO.
SEAL SYSTEM DRAWING	IP-SPT021-ON-MA-145-P103-0013
MOTOR OUTLINE DRAWING	IP-SPT021-ON-MA-145-P103-0016
COUPLING DRAWING AND BOM	IP-SPT021-ON-MA-145-P103-0008

Code1	✗ (Approved) Vendor to submit "For Final" (No comment & release for manufacturing)
Code2	✓ (Approved with comments) Vendor shall correct / revise & submit it as "For Final" (Released for manufacturing if change incorporated as indicated)
Code3	✓ (Commented) : Vendor shall correct / revise & resubmit it as "For Approval" or the date specified : (Corrected documents to be)
Code4	✓ (Not Acceptable quality (Reject))

DATE: 28-01-2014  
S. Shahrarian  
Machinery

8	28 Jan 2014	FOR APPROVAL	DBP	Tino	Ryan
7	14 Dec 2013	FOR APPROVAL	DBP	Tino	Ryan
6	23 Nov 2013	FOR APPROVAL	DBP	Tino	Ryan
5	17 Oct 2013	FOR APPROVAL	DBP	Tino	Ryan
4	DATE	DESCRIPTION	DBP	PREF	CHD

PROJECT NO.:	POCC-572-86-35	DOC CLASS:	
SCALE:			
Propone Truck Unloading Pump	145-P-103		
GENERAL ARRANGEMENT DRAWING			
DRAWING NO.:	IP-SPT021-ON-MA-145-P103-0008	SHEET NO.:	1 OF 1
REV.:		REV.:	7