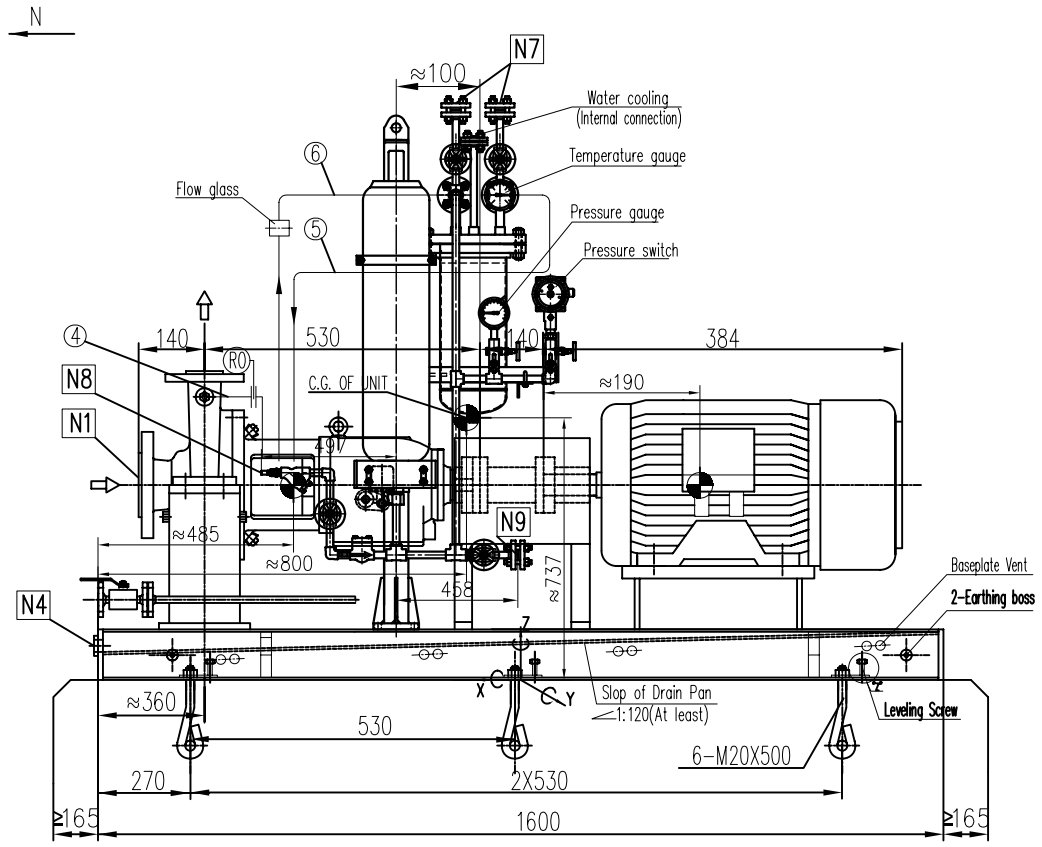

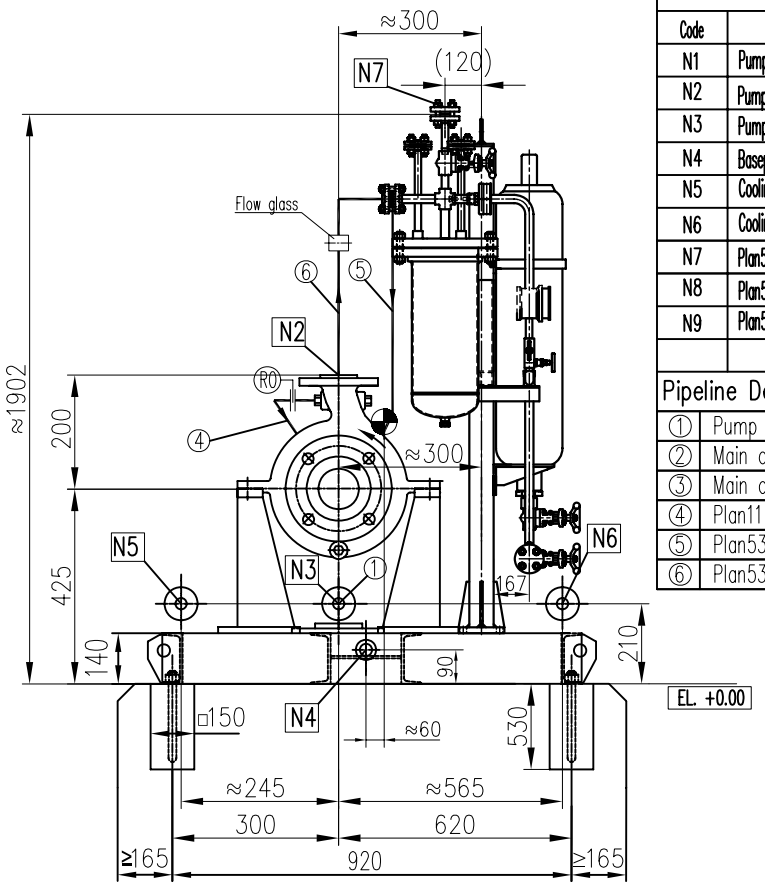

PROCESS CONNECTIONS			
Code	Description	Size & Rating	Remark
N1	Pump Suction Flange	2", ASME B16.5 300LB RF	
N2	Pump Discharge Flange	1 1/4", ASME B16.5 300LB RF	
N3	Pump Drain Flange	3/4", ASME B16.5 300LB RF	Flange with ball valve
N4	Baseplate Drain	NPT 2"	
N5	Cooling Water Inlet Flange	1", ASME B16.5 150LB RF	Flange with ball valve
N6	Cooling Water Outlet Flange	1", ASME B16.5 150LB RF	Flange with ball valve
N7	Plan53B Vent	1/2", ASME B16.5 1500LB RF	Flange with gate valve
N8	Plan53B Filling	1/2" NPT, Quick Fittings	
N9	Plan53B Drain	1/2", ASME B16.5 1500LB RF	Flange with gate valve

Pipeline Description	
①	Pump Drain
②	Main cooling water inlet
③	Main cooling water outlet
④	Plan11 Flushing pipeline
⑤	Plan53B Flushing pipeline (to seal chamber)
⑥	Plan53B Flushing pipeline (from seal chamber)

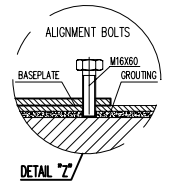

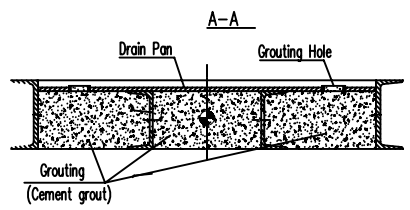

PUMP INFORMATION	
Item No:	01-120-P-6
Service:	HYDROCORBONS RECOVERY PUMP
Model:	EAP 32K1-160-9
Seal Plan:	11+53B
Motor:	2.2KW-2885RPM
Motor Critical Speed:	11000RPM

REFERENCE DRAWING	DWG NO.
Seal System Drawing	BU-01-VD-307-MA-DRW-1206-068
Motor outline Drawing	BU-01-VD-307-MA-DRW-1206-100
Coupling Drawing	BU-01-VD-307-MA-DRW-1206-036
Pump data sheet	BU-01-VD-307-MA-DSH-1206-004

Note:
1. The pump is self vent.
2. Rotation: Clockwise viewed from drive-end.
3. Vibration Level complies to API610 requirement, table 8 and table 9.

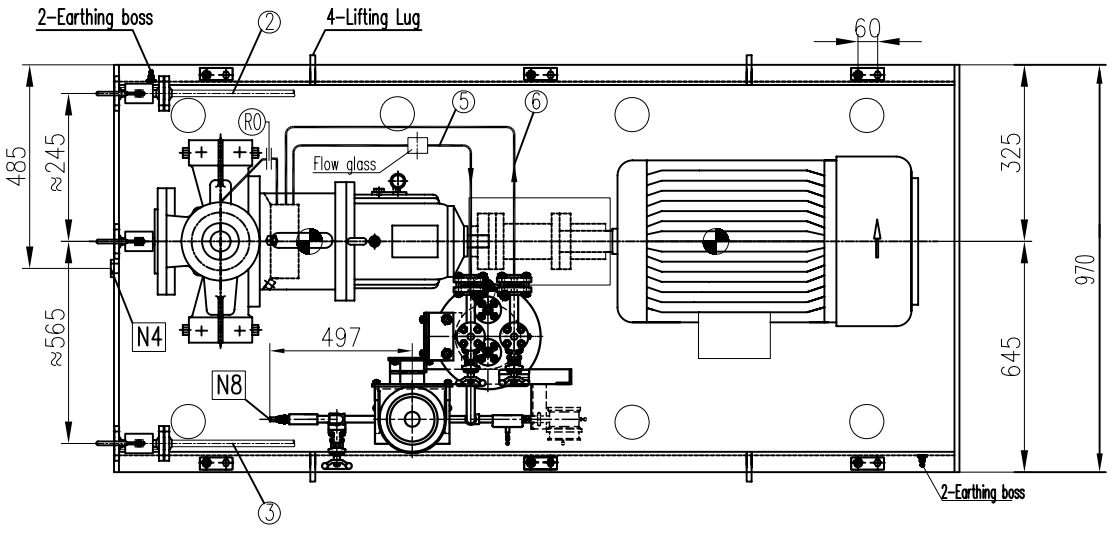

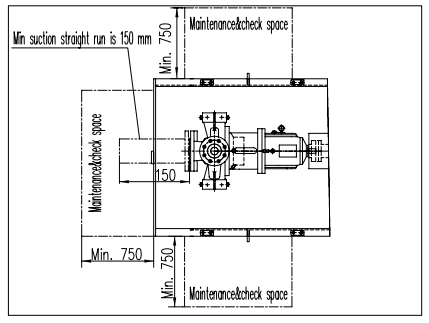

WEIGHT TABLE		
PUMP	95	KG
MOTOR	45.6	KG
SEAL SYSTEM	336	KG
BASEPLATE	149	KG
OTHERS	50	KG
TOTAL WEIGHT	675.6	KG
ROTOR WEIGHT	11.5	KG
MAX. MAINTENANCE WEIGHT	61.7	KG

Remark:
1. Moment of inertia: 0.021 kg.m2

Static loading calculation results		
FXStatic=±	3200	N
FYStatic=±	2580	N
FZStatic=±	-3672/9552	N
MXStatic=±	3169	N*m
MYStatic=±	4934/3106	N*m
MZStatic=±	2734	N*m

Dynamic loading calculation results		
FXdynamic=±	0	N
FYdynamic=±	22	N
FZdynamic=±	22	N
MXdynamic=±	16/2	N*m
MYdynamic=±	10	N*m
MZdynamic=±	10	N*m

Code1	☑ (Approved) No comment and the document is released for Manufacturing
Code2	☐ (Approved with comments) Vendor shall correct, revise and resubmit the document. The document is released for manufacturing
Code3	☐ (Commented) : Vendor shall correct / revise & resubmit document
Code4	☐ Not Acceptable quality (Reject)

The above checking result by EIED shall in no way relieve Vendor of any liability, obligation and responsibility out of the purchase order and the mutual agreement in writing

EIED BUSHEHR PROJECT

DATE : 4 November 2015
DEPT: MA
Signatu: M.F.
CODE 1

REV.	DATE	PURPOSE OF ISSUE	PREP. BY	CHKD. BY	APPD. BY	AUTH. BY
02	29/08/15	FOR APPROVAL	Eric	Andy	Tino	AAP
01	08/07/15	FOR APPROVAL	Eric	Andy	Tino	AAP
00	25/03/15	FOR APPROVAL	Eric	Andy	Tino	AAP

Gas Sweetening, Sulphur Recovery, C2 Recovery, Fractionation and Inter Connection Pipeline Between Plants Project

BUSHEHR PETROCHEMICAL COMPANY

P.O No.: A315.760AME | SCALE:

DEEP BLUE PUMP

EIED Energy Industries Engineering & Design Co.

DRAWING TITLE:
Pump Outline Drawing for HYDROCORBONS RECOVERY PUMP
01-120-P-6

DRAWING No.: BU-01-VD-307-MA-DRW-1206-004 | SHEET No. 1 OF 1

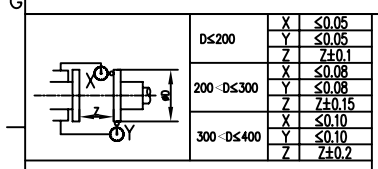

MAX. ALLOWABLE MISALIGNMENT(mm)

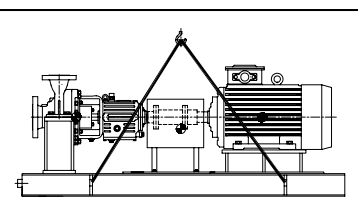

Anchor Bolt
M20×500
Anchor bolts will be supplied by DBP

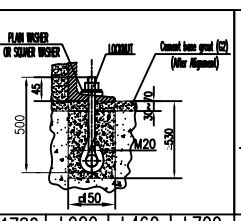

PUMP END

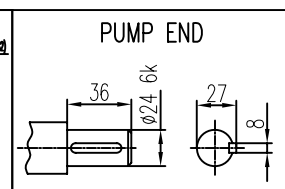

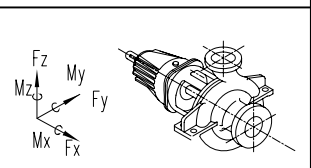

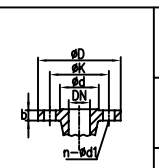

Nozzle Allowable Force & Moment							
DISCHARGE	1 1/4"	±1420	±1160	±1780	±920	±460	±700
	inch	Fx	Fy	Fz	Mx	My	Mz
	DN	Force (N)			Moment(Nm)		
SUCTION	2"	±1780	±1420	±1160	±920	±460	±700
	inch	Fx	Fy	Fz	Mx	My	Mz
	DN	Force (N)			Moment(Nm)		

EARTHING BOSS

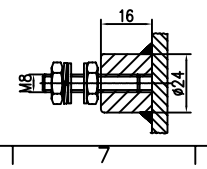

MOTOR END